

STATE ENGINEER  
Salem, Oregon

CLAG  
02154

# Well Record

GR- 1292

STATE WELL NO. 5/1W-14J (1)  
COUNTY Clackamas  
APPLICATION NO. GR- 1244

OWNER: Roy O. or Mildred O. Bliven


MAILING ADDRESS: Rt. 2, Box 109 A

LOCATION OF WELL: Owner's No. \_\_\_\_\_

CITY AND STATE: Woodburn, Oregon

NE 1/4 SE 1/4 Sec. 14 T. 5 S., R. 1 W., W.M.

Bearing and distance from section or subdivision corner 1646' N. & 930' W. from SE cor. Sec. 14.

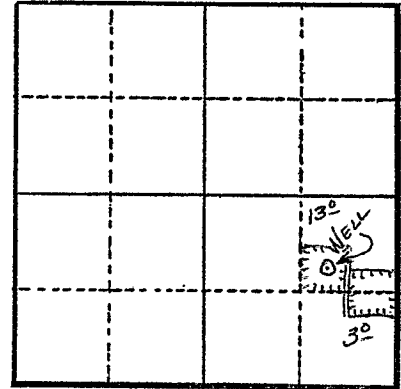

Section 14

Altitude at well \_\_\_\_\_

TYPE OF WELL: Drilled Date Constructed 1951

Depth drilled 112 ft. Depth cased 102 ft.

CASING RECORD:  
8 inch

FINISH:

AQUIFERS:

WATER LEVEL:  
28 ft.

PUMPING EQUIPMENT: Type Berkeley turbine H.P. 5  
Capacity 100 G.P.M.

WELL TESTS:  
Drawdown 40 ft. after \_\_\_\_\_ hours 180 G.P.M.  
Drawdown \_\_\_\_\_ ft. after \_\_\_\_\_ hours \_\_\_\_\_ G.P.M.

USE OF WATER Irrigation Temp. \_\_\_\_\_ °F. \_\_\_\_\_, 19\_\_\_\_

SOURCE OF INFORMATION G. R. Record

DRILLER or DIGGER J. W. Beck

ADDITIONAL DATA:  
Log \_\_\_\_\_ Water Level Measurements \_\_\_\_\_ Chemical Analysis \_\_\_\_\_ Aquifer Test \_\_\_\_\_

REMARKS:

Log: Silt 0 to 22 ft.  
Light blue hard pan 22 to 28 ft.  
Blue clay 28 to 48 ft.  
Cement gravel 48 to 60 ft.  
Loose gravel 60 to 73 ft. ✓  
Blue clay 73 to 112 ft.  
Water gravel 112 to -----

Irrigation of 20 acres.