The original and first copy WATER WELL REPOR of this report are to be DE 65 1974 State Well No. 55/1W-24 TA filed with the CLAC STATE OF OREGON 0217 (ho yot write above this line) SALEM, OREGOII STATE ENGINEER, SALEM, OREGON 97310 STATE ENGINEER Permit No. within 30 days from the date well completion. (1) OWNER: Van Veen Nursery (10) LOCATION OF WELL: c/o Name Ross Iverson County Clackamas Driller's well number Address Rte. 2. Box 97. Woodburn, Oregon 97071 14 S.W. Section 24 T. 5 S. R. 1 W. W.M. Bearing and distance from section or subdivision corner (2) TYPE OF WORK (check): New Well Deepening [Reconditioning [Abandon 🖂 If abandonment, describe material and procedure in Item 12. (11) WATER LEVEL: Completed well. (3) TYPE OF WELL: (4) PROPOSED USE (check): Depth at which water was first found Rotary Driven [Domestic | Industrial | Municipal | Static level ft. below land surface. Cable Jetted 🔲 Dug Bored | Irrigation Test Well | Other Artesian pressure lbs. per square inch. Date CASING INSTALLED: Threaded | Welded -(12) WELL LOG: 10 " Diam. from 1+ 10 ft. to 250 ft. Gage Diameter of well below casing .Q. Depth drilled 318 ft. Depth of completed well Formation: Describe color, texture, grain size and structure of materials; " Diam from ... ft. to and show thickness and nature of each stratum and aquifer penetrated, with at least one entry for each change of formation. Report each change in **PERFORATIONS:** position of Static Water Level and indicate principal water-bearing strata. Perforated? X Yes | No. ype of perforator used Manufacturer MATERIAL Size of perforations 3/16 Tepseil, Brewn O Clay, Brown, Silty 2 11 11 perforations from Clay, Brown, Soft 21 Clay, Med. Hard, gritty 17 perforations from Gravel, Mod. 21 26 (7) SCREENS: Well screen installed?

Yes Gravel fine .course .sand 26 **28** Conglomerate, Med,. **2**8 32 Siltstene brewn med har 32 Diam. Slot size Set from Sandstene, med. br. seft 41 Diam. Slot size Set from ft. to ft. Sand br. . course little gr 4] Conglon. med. 59 Drawdown is amount water level is lowered below static level (8) WELL TESTS: Sandatone br. med hard 59 67 Was a pump test made? Yes No If yes, by whom? <u>Sandstene,blue,elayey</u> gal./min. with 182 ft. drawdown after Yield: Claystone blue & elay hrs. Clay, blue soft 74 110 Gravel. fine 110 111 Bailer test XX gal./min. with ft. drawdown after hrs. Clay, grey Artesian flow xxClay, grey, fine gravel g.p.m. aperature of water X Depth artesian flow encountered Work started July 11,74 19 Completed Date well drilling machine moved off of well (9) CONSTRUCTION: Drilling Machine Operator's Certification: Well seal-Material used This well was constructed under my direct supervision. Materials used and information reported above are true to my Well sealed from land surface to ... Diameter of well bore to bottom of seal . best knowledge and belief. [Signed] (Drilling Machine Operator) Date 9-6, 1974 Diameter of we, bore below seal cement used in well seal Number of sack Drilling Machine Operator's License No. 138 Number of sacks of bentonite used in well seal .. Brand name of bentonite Water Well Contractor's Certification: Number of pounds of bentonite per 100 gallons This well was drilled under my jurisdiction and this report is true to the best of my knowledge and belief. Name R. Stadeli & Sons Inc.

(Type or print) Was a drive shoe used? Yes No Plugs Size: location ft. Did any strata contain unusable water?

Yes No Address Rte. 3. Box 169. Silverton. Oregon 97381 Type of water? depth of strata Method of sealing strata off Was well gravel packed? Yes No Size of gravel: ... Contractor's License No. 296 Date Sept. 27,74, 19

NOTICE TO WATER WELL CONTRACTOR

Gravel placed from .

NOTICE TO WATER WELL CONTRACTOR The original and first copy of this report are to be filed with the


STATE ENGINEER, SALEM, OREGON 97310 within 30 days from the date ... of well completion.

WATER WELL REPORT

STATE OF OREGON

(Please type or print)

(Do not write above this line)

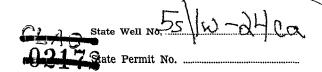

(1) OWNER: Van Veen Nursery	(10) LOCATION OF WELL:	4	
Name/o Ress Iverson, continued	County Driller's well number		
Address	1/4 1/4 Section T.	R. W.M.	
(2) TYPE OF WORK (check):	Bearing and distance from section or subdivision corner		
New Well Deepening Reconditioning Abandon			
If abandonment, describe material and procedure in Item 12.	(11) WATER LEVEL: Completed well.		
(3) TYPE OF WELL: (4) PROPOSED USE (check):	Depth at which water was first found ft.		
Rotary Driven Domestic Industrial, Municipal Domestic Municipal	Static level ft. below land	surface. Date	
Dug	Artesian pressure lbs. per square inch. Date		
CASING INSTALLED: Threaded □ Welded □	(12) WELL LOG: Diameter of well below casing		
ft. Gage ft. to ft. Gage	Depth drilled, ft. Depth of completed well ft.		
ft. Gage ft. Gage	Formation: Describe color, texture, grain size and structure of materials; and show thickness and nature of each stratum and aquifer penetrated, with at least one entry for each change of formation. Report each change in		
DEDECT A MICAYO			
PERFORATIONS: Perforated? ☐ Yes ☐ No.	position of Static Water Level and indicate pri	ncipal water-bearing strata.	
pe of perforator used	MATERIAL	From To SWL	
Size of perforations in. by in.	Clay grey and blue	125 160	
perforations from ft. to ft.		1160 163	
ft. to ft.	Sandstone blue soft	163 165	
perforations from ft. to ft.	Siltatone grey	165 168	
(7) CODEENC.	Clay, grey seft	168 177	
(7) SCREENS: Well screen installed? Yes No	Sandstone, blue	177 181	
Manufacturer's Name	Clay grey sandy	181 188	
Type Model No.	Clay blue sticky	188 225	
·	Sand, very fine silty	225 227	
Diam. Slot size Set from ft. to ft.	Grey clay, course sand		
(8) WELL TESTS: Drawdown is amount water level is	Wood	227 237	
lowered below static level	Cley blue, elay grey	237 262	
Was a pump test made? Yes No If yes, by whom?	Cley green Claystone, grey	262 279 279 318	
Yield: gal./min. with ft. drawdown after hrs.	Cany Booker Croy	13 JIO	
" " "			
, n n			
Bailer test gal./min. with ft. drawdown after hrs.			
Artesian flow g.p.m.			
perature of water Depth artesian flow encountered ft.	Work started July 11 19 74 Complete	ted 19	
(9) CONSTRUCTION:	Date well drilling machine moved off of well	19	
Well seal—Material used	Drilling Machine Operator's Certification		
Well sealed from land surface to ft.	This well was constructed under my direct supervision. Materials used and information reported above are true to my		
Diameter of well bore to bottom of seal in.	best knowledge and belief.		
Diameter of well bore below seal in.	[Signed] Date, 19		
Number of sacks of cement used in well seal sacks			
Number of sacks of bentonite used in well seal sacks	Drilling Machine Operator's License No.		
Brand name of bentonite	Windowski Control of C		
Number of pounds of bentonite per 100 gallons	Water Well Contractor's Certification:		
of water	This well was drilled under my jurisdiction and this report is true to the best of my knowledge and belief.		
Was a drive shoe used? 🗆 Yes 🗀 No Plugs Size: location ft.			
Did any strata contain unusable water? Yes No	Name (Person, firm or corporation) (Type or print)		
Type of water? depth of strata	Address		
Method of sealing strata off	[Ciamod]		
Was well gravel packed? ☐ Yes ☐ No Size of gravel:	[Signed](Water Well Contractor)		
Gravel placed from ft. to ft.	Contractor's License No Date	19	