

STATE ENGINEER  
Salem, Oregon

02184 Well Record  
CLAC

STATE WELL NO. 5/1W-24C  
COUNTY Clackamas  
APPLICATION NO. GR-3627

OWNER: Burt Burton Helyn Burton

MAILING ADDRESS: Route 2, Box 103


LOCATION OF WELL: Owner's No.

CITY AND STATE: Woodburn, Oregon

NE 1/4 NW 1/4 Sec. 24 T. 5 N. S, R. 1 E. W., W.M.

Bearing and distance from section or subdivision

corner 339.6' W. & 257' S. of N 1/4 Cor. T.J. Chase D.L.C.

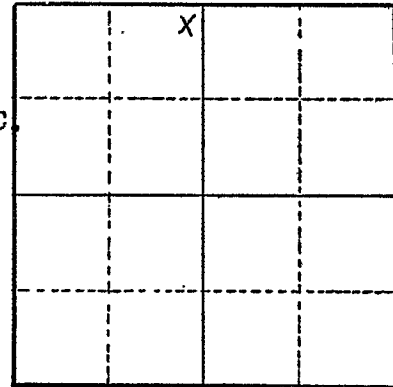

Section 24

Altitude at well

TYPE OF WELL: Drilled Date Constructed May, 1945

Depth drilled 92 feet Depth cased 92 feet

CASING RECORD:

6 inch steel casing set to 92 feet 2 inches

FINISH:

AQUIFERS:

WATER LEVEL:

20 feet below surface

PUMPING EQUIPMENT: Type Fairbanks Morse turbine H.P. 2

Capacity 40 G.P.M.

WELL TESTS:

Drawdown 50 ft. after 125 hours G.P.M.

Drawdown ft. after hours G.P.M.

USE OF WATER Irrigation Temp. °F., 19

SOURCE OF INFORMATION Well Registration Statement

DRILLER or DIGGER B. F. Ballweber

ADDITIONAL DATA:

Log X Water Level Measurements Chemical Analysis Aquifer Test

REMARKS:

Log:

	Thickness	Depth to Bottom
clay	30	30
sand	50	80
gravel	12	92

3322