

STATE ENGINEER  
Salem, Oregon

# Well Record

STATE WELL NO. 5/1W-240  
COUNTY Clackamas  
APPLICATION NO. GR-1382

**CLAG**  
**02186**

GR- 1339

OWNER: Ross Iverson


MAILING ADDRESS: Rt. 2, Box 97

LOCATION OF WELL: Owner's No. \_\_\_\_\_

CITY AND STATE: Woodburn, Oregon

SW ¼ SE ¼ Sec. 24 T. 5 S., R. 1 W., W.M.

Bearing and distance from section or subdivision  
corner S.40°40'E. 2752' from NW cor. of John W.  
Nehman DLG.

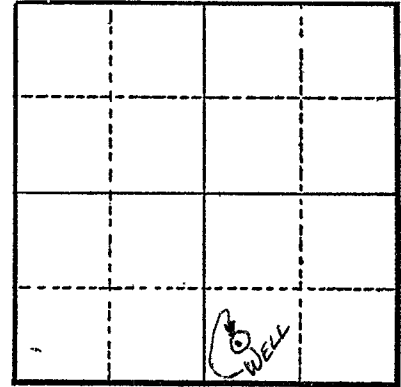

Altitude at well 150 ft.

TYPE OF WELL: Drilled Date Constructed 1947

Depth drilled 90 ft. Depth cased 90 ft.

Section 24

CASING RECORD:

12 inch

FINISH:

AQUIFERS:

WATER LEVEL:

Flowing

PUMPING EQUIPMENT: Type Peerless turbine H.P. 7½

Capacity 145 G.P.M.

WELL TESTS:

Drawdown 60 ft. after \_\_\_\_\_ hours 145 G.P.M.

Drawdown \_\_\_\_\_ ft. after \_\_\_\_\_ hours \_\_\_\_\_ G.P.M.

USE OF WATER Irrigation Temp. \_\_\_\_\_ °F. \_\_\_\_\_, 19\_\_\_\_\_

SOURCE OF INFORMATION G. R. Record

DRILLER or DIGGER Norman Service

ADDITIONAL DATA:

Log N.A. Water Level Measurements \_\_\_\_\_ Chemical Analysis \_\_\_\_\_ Aquifer Test \_\_\_\_\_

REMARKS:

Irrigation of 17.4 acres.