

STATE ENGINEER
Salem, Oregon

CLAC Well Record
02249

STATE WELL NO. 5/1-3D
COUNTY Clackamas
APPLICATION NO. GR-3713


OWNER: Herman Martinson
MAILING ADDRESS: Route 2, Box 362
CITY AND STATE: Canby, Oregon

LOCATION OF WELL: Owner's No.
NW 1/4 NW 1/4 Sec. 3 T. 5 S., R. 1 E., W.M.

Bearing and distance from section or subdivision
corner 20 rds. to NW cor. of Sec. 3

Altitude at well

TYPE OF WELL: Drilled Date Constructed Oct., 1947
Depth drilled 118 feet Depth cased 100 feet

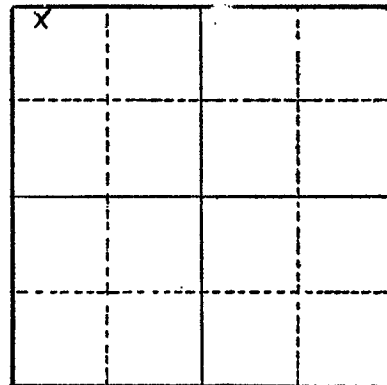

Section 3

CASING RECORD:

6 inch casing set to 100 feet

FINISH:

AQUIFERS:

WATER LEVEL:

PUMPING EQUIPMENT: Type Berkley turbine H.P. 5
Capacity 50 G.P.M.

WELL TESTS:

Drawdown ft. after hours G.P.M.
Drawdown ft. after hours G.P.M.

USE OF WATER Irrigation Temp. °F. 19

SOURCE OF INFORMATION Well Registration Statement

DRILLER or DIGGER J. T. Miller

ADDITIONAL DATA:

Log Water Level Measurements Chemical Analysis Aquifer Test

REMARKS:

3374