

STATE ENGINEER
Salem, Oregon

CLAC
02364

Well Record

STATE WELL NO. 5/1-5N
COUNTY CLACKAMAS
APPLICATION NO. GR-2420

OWNER: Kristian R. Schau

MAILING
ADDRESS:

Rt. 1, Box 119

LOCATION OF WELL: Owner's No.


CITY AND
STATE:

Hubbard, Oregon

SW 1/4 SW 1/4 Sec. 5 T. 5 S. R. 1 E W.M.

Bearing and distance from section or subdivision

corner 650' E. & 320' N.

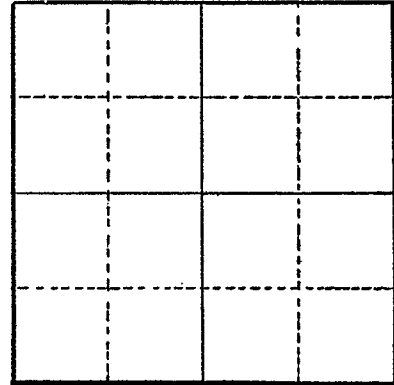

Altitude at well

TYPE OF WELL: Drilled Date Constructed 1948

Depth drilled 135 Depth cased 135?

Section

CASING RECORD:

6-inch

FINISH:

AQUIFERS:

WATER LEVEL:

50-feet

PUMPING EQUIPMENT: Type Turbine H.P. 5
Capacity 100 G.P.M.

WELL TESTS:

Drawdown Small after hours ?? G.P.M.

Drawdown ft. after hours G.P.M.

USE OF WATER Irrigation Temp. °F. 19

SOURCE OF INFORMATION GR-2300

DRILLER or DIGGER

ADDITIONAL DATA:

Log Water Level Measurements Chemical Analysis Aquifer Test

REMARKS: