

STATE ENGINEER
Salem, Oregon

CLAC
02376

Well Record

STATE WELL NO. 5/1B-6R
COUNTY Clackamas
APPLICATION NO. GR-2752

OWNER: Roy Christner
MAILING ADDRESS: Route 1, Box 111
CITY AND STATE: Hubbard, Oregon

LOCATION OF WELL: Owner's No.
SE 1/4 SE 1/4 Sec. 6 T. 5 S. R. 1 E. W.M.


Bearing and distance from section or subdivision
corner 1250 feet North and 150 feet West from the
SE Corner, Section 6.

Altitude at well

TYPE OF WELL: Drilled Date Constructed 1944

Depth drilled 83 feet Depth cased

CASING RECORD:

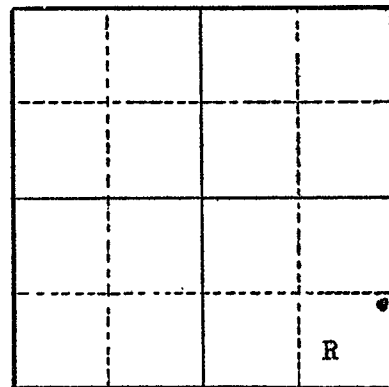

Section 6

FINISH:

AQUIFERS:

WATER LEVEL:

28 feet

PUMPING EQUIPMENT: Type Peerless H.P. 3
Capacity 80 G.P.M.

WELL TESTS:

Drawdown 50 ft. after 60 hours G.P.M.
Drawdown ft. after hours G.P.M.

USE OF WATER Irrigation Temp. °F., 19

SOURCE OF INFORMATION GR-4031

DRILLER or DIGGER Pete Harnack

ADDITIONAL DATA:

Log (NA) Water Level Measurements Chemical Analysis Aquifer Test

REMARKS: