

NOTICE TO WATER WELL CONTRACTOR
The original and first copy
of this report are to be
filed with the

WATER WELL REPORT

CLAC State Well No. 53/12-7
02380 State Permit No.

STATE ENGINEER, SALEM, OREGON 97310
within 30 days from the date
of well completion.

STATE OF OREGON
(Please type or print)

(Do not write above this line)

(1) OWNER:

Name Otto Straub
Address Rt. 1, Box 231
Hubbard, Ore. 97032

(2) TYPE OF WORK (check):

New Well [X] Deepening [] Reconditioning [] Abandon []
If abandonment, describe material and procedure in Item 12.

(3) TYPE OF WELL:

Rotary [X] Driven []
Cable [] Jetted []
Dug [] Bored []

(4) PROPOSED USE (check):

Domestic [X] Industrial [] Municipal []
Irrigation [X] Test Well [] Other []

CASING INSTALLED:

12" Diam. from 299'7" ft. to 337'3" ft. Gage .250
12" Diam. from 337'3" ft. to 359'9" ft. Gage .250
12" Diam. from 359'9" ft. to 358'5" ft. Gage .277

PERFORATIONS:

Perforated? [X] Yes [] No.

Type of perforator used torch
Size of perforations 3/8 in. by 6 in.
2" 426 perforations from 299'7" ft. to 337'3" ft.
3" 304 perforations from 318'2" ft. to 358'5" ft.

(7) SCREENS:

Well screen installed? [] Yes [X] No

Manufacturer's Name
Type Model No.
Diam. Slot size Set from ft. to ft.
Diam. Slot size Set from ft. to ft.

(8) WELL TESTS:

Drawdown is amount water level is lowered below static level

Was a pump test made? [X] Yes [] No If yes, by whom? Driller
Yield: gal./min. with ft. drawdown after hrs.
See Sheet Attached
Ball test gal./min. with ft. drawdown after hrs.
Artesian flow g.p.m.

(9) CONSTRUCTION:

Pressure grouted
zonalite, intrusion aid
Well seal-Material used cement & admix
Well sealed from land surface to 0 to 25 & 38 to 63 ft.
Diameter of well bore to bottom of seal 36 in.
Diameter of well bore below seal 36 in.
Number of sacks of cement used in well seal 116 sacks
Number of sacks of aggregate used in well seal 70 sacks
Brand name of aggregate zonalite
Number of pounds of bentonite per 100 gallons
of water lbs./100 gals.
Was a drive shoe used? [] Yes [X] No Plugs Size: location ft.
Did any strata contain unusable water? [] Yes [X] No

Type of water? depth of strata
Method of sealing strata off
Was well gravel packed? [X] Yes [] No Size of gravel: 3/4 - 1/2
Gravel placed from 63 ft. to bottom ft.

(10) LOCATION OF WELL:

County Clackamas Driller's well number 7602
1/4 1/4 Section 7 T. 5S R. 1E W.M.
Bearing and distance from section or subdivision corner

(11) WATER LEVEL: Completed well.

Depth at which water was first found 46 ft.
Static level 72 ft. below land surface. Date 1-30-76
Artesian pressure lbs. per square inch. Date

(12) WELL LOG:

Diameter of well below casing

Depth drilled 353 ft. Depth of completed well 358 ft.

Formation: Describe color, texture, grain size and structure of materials; and show thickness and nature of each stratum and aquifer penetrated, with at least one entry for each change of formation. Report each change in position of Static Water Level and indicate principal water-bearing strata.

Table with 4 columns: MATERIAL, From, To, SWL. Content includes 'See Sheet Attached' and '*6" diam from 2 ft. to 63' gravel feed'.

Work started 8-26 19 76 Completed 3-2- 19 76
Date well drilling machine moved off of well 3-2 19 76

Drilling Machine Operator's Certification:

This well was constructed under my direct supervision. Materials used and information reported above are true to my best knowledge and belief.

(Signed) Milo Schneider Date 3-17, 19 76
(Drilling Machine Operator)

Drilling Machine Operator's License No. 212

Water Well Contractor's Certification:

This well was drilled under my jurisdiction and this report is true to the best of my knowledge and belief.

Name Schneider Equipment, Inc.
(Person, firm or corporation) (Type or print)

Address Star Rt., Box 97, St. Paul, Ore.

(Signed) Milo Schneider
(Water Well Contractor)

Contractor's License No. 387 Date 3-17 19 76


CLAC
2380

7602

Otto Straub


Material	To	From
Brown dirt	0	30
Brown clay	30	35
Brown sandy clay	35	42
Grey sand	42	46
Grey sandy clay	46	48
Dark grey clay	48	52
Blue clay	52	54
Dark basaltic lava	54	63
Brown poorly graded fine gravel	63	69
Poorly graded large gravel (to 4")	69	74
Brown clay	74	76
Grey clay	76	88
Brown clay mixed with wood fibre	88	92
Grey clay	92	95
Brown sand and poorly graded gravel	95	103
Poorly graded large gravel & boulders	103	117
Dark sandy grey clay	117	120
Light grey clay	120	125
Brown clay mixed with wood fiber	125	127
Grey sandy clay with wood fiber	127	131
Hard grey clay	131	145
Blue clay	145	153
Blue clay	153	170
Blue green clay	170	190
Blue claystone	190	200
Blue clay	200	273
Grey clay	273	300
Dark grey clay	300	306
Dark black claystone	306	315
Medium fine to coarse black sand	315	326
Coarse black sand	326	332
Brown clay	332	334
Grey clay w/ some sand imbedded	334	336
Grey clay w/ some sand imbedded in	336	353

Water Level - Depth in Feet

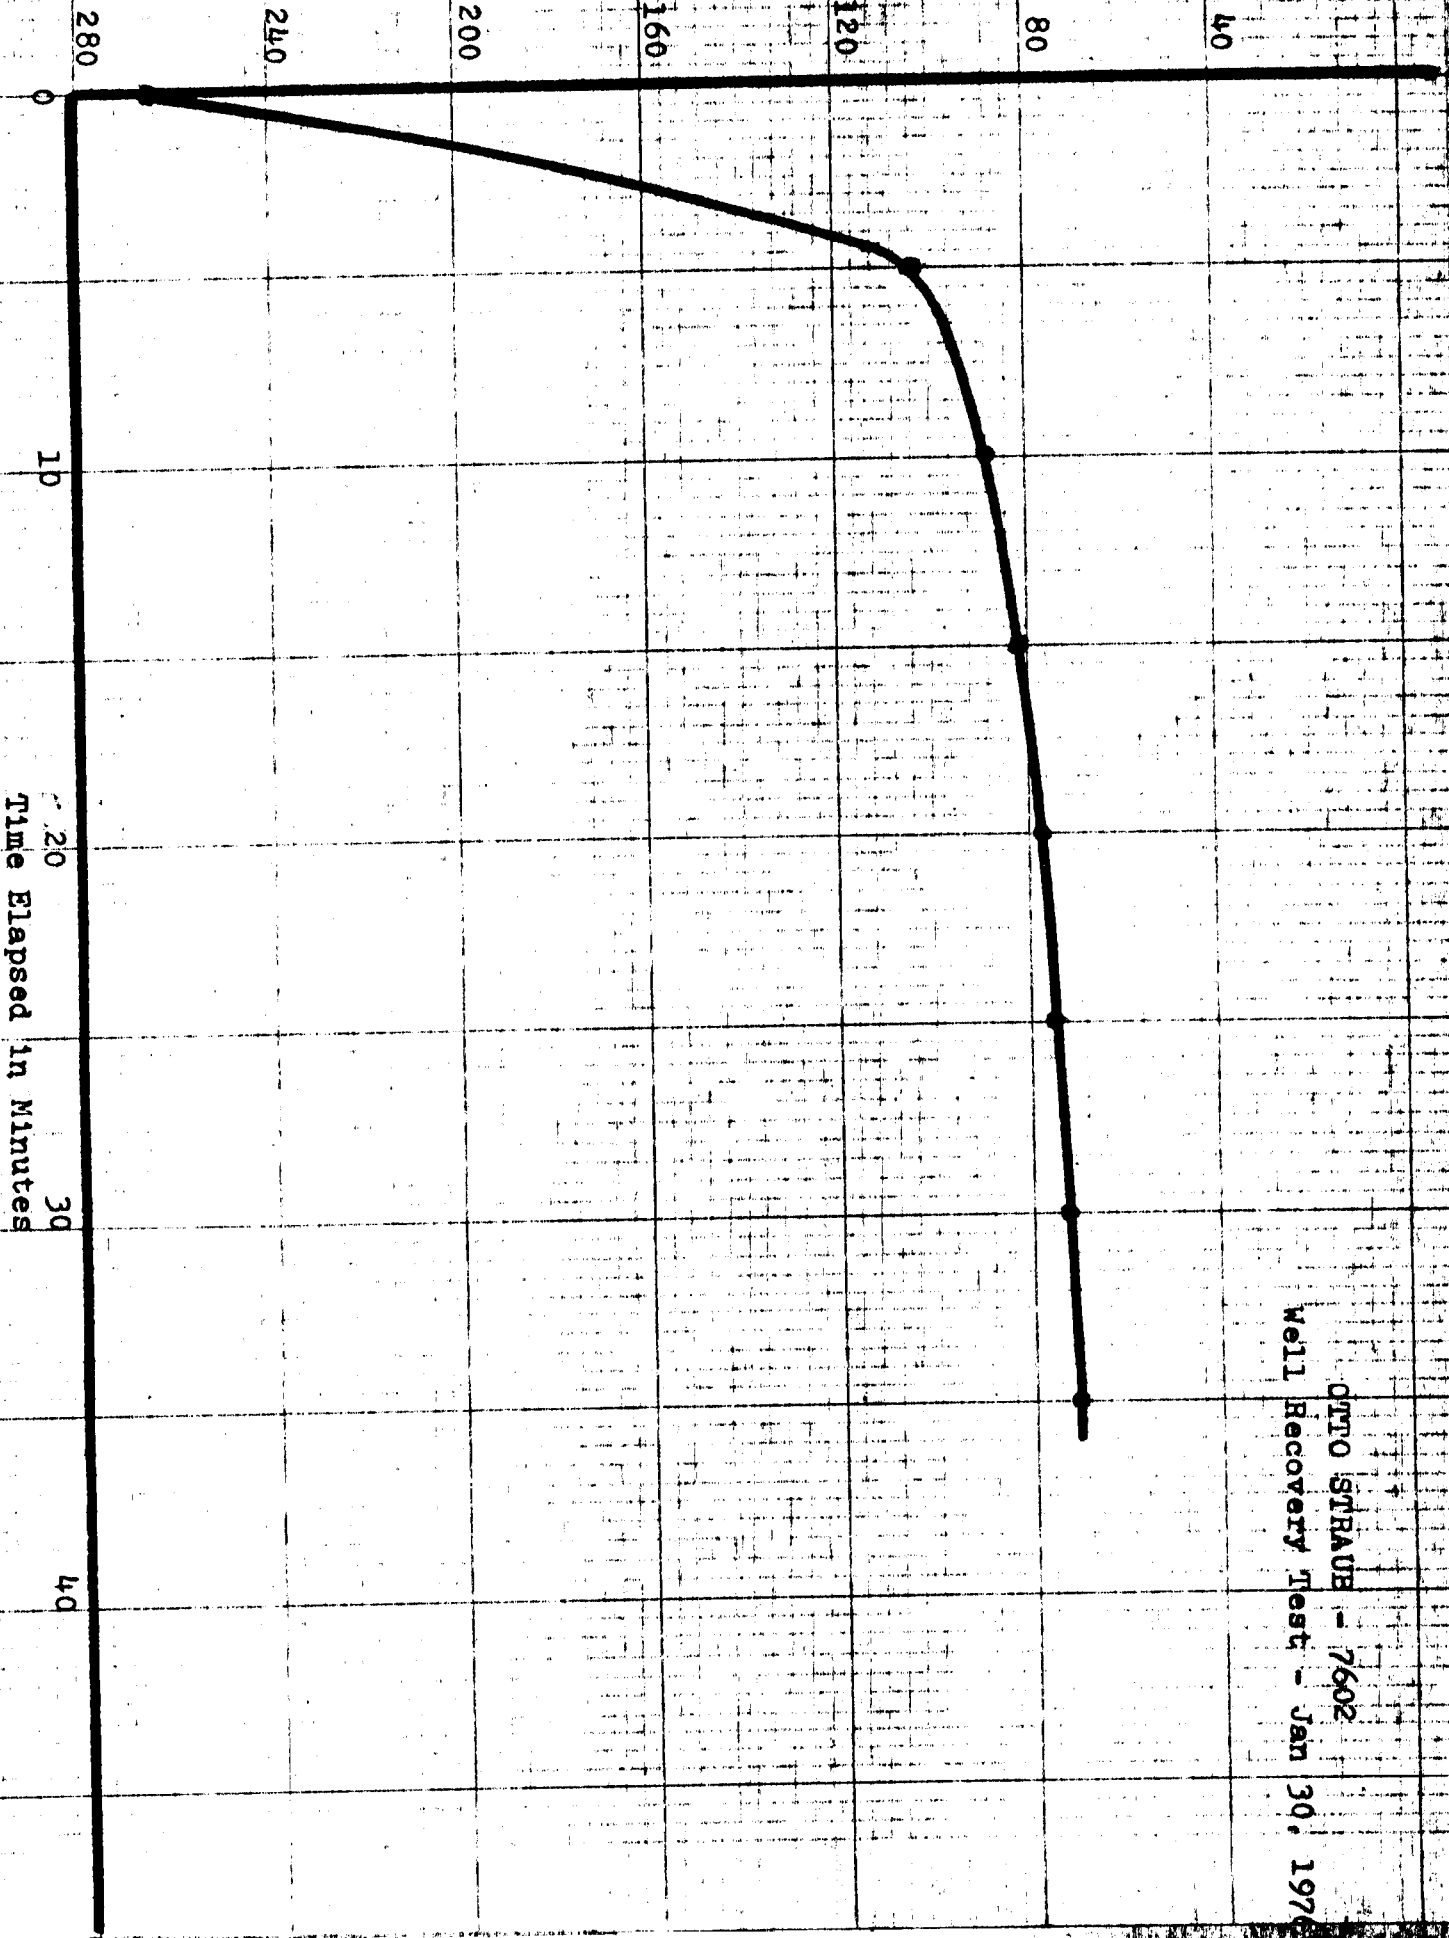

DTMO STRAUB - 7602
Well Recovery Test - Jan 30, 1976

Pumping Level - Depth in Feet

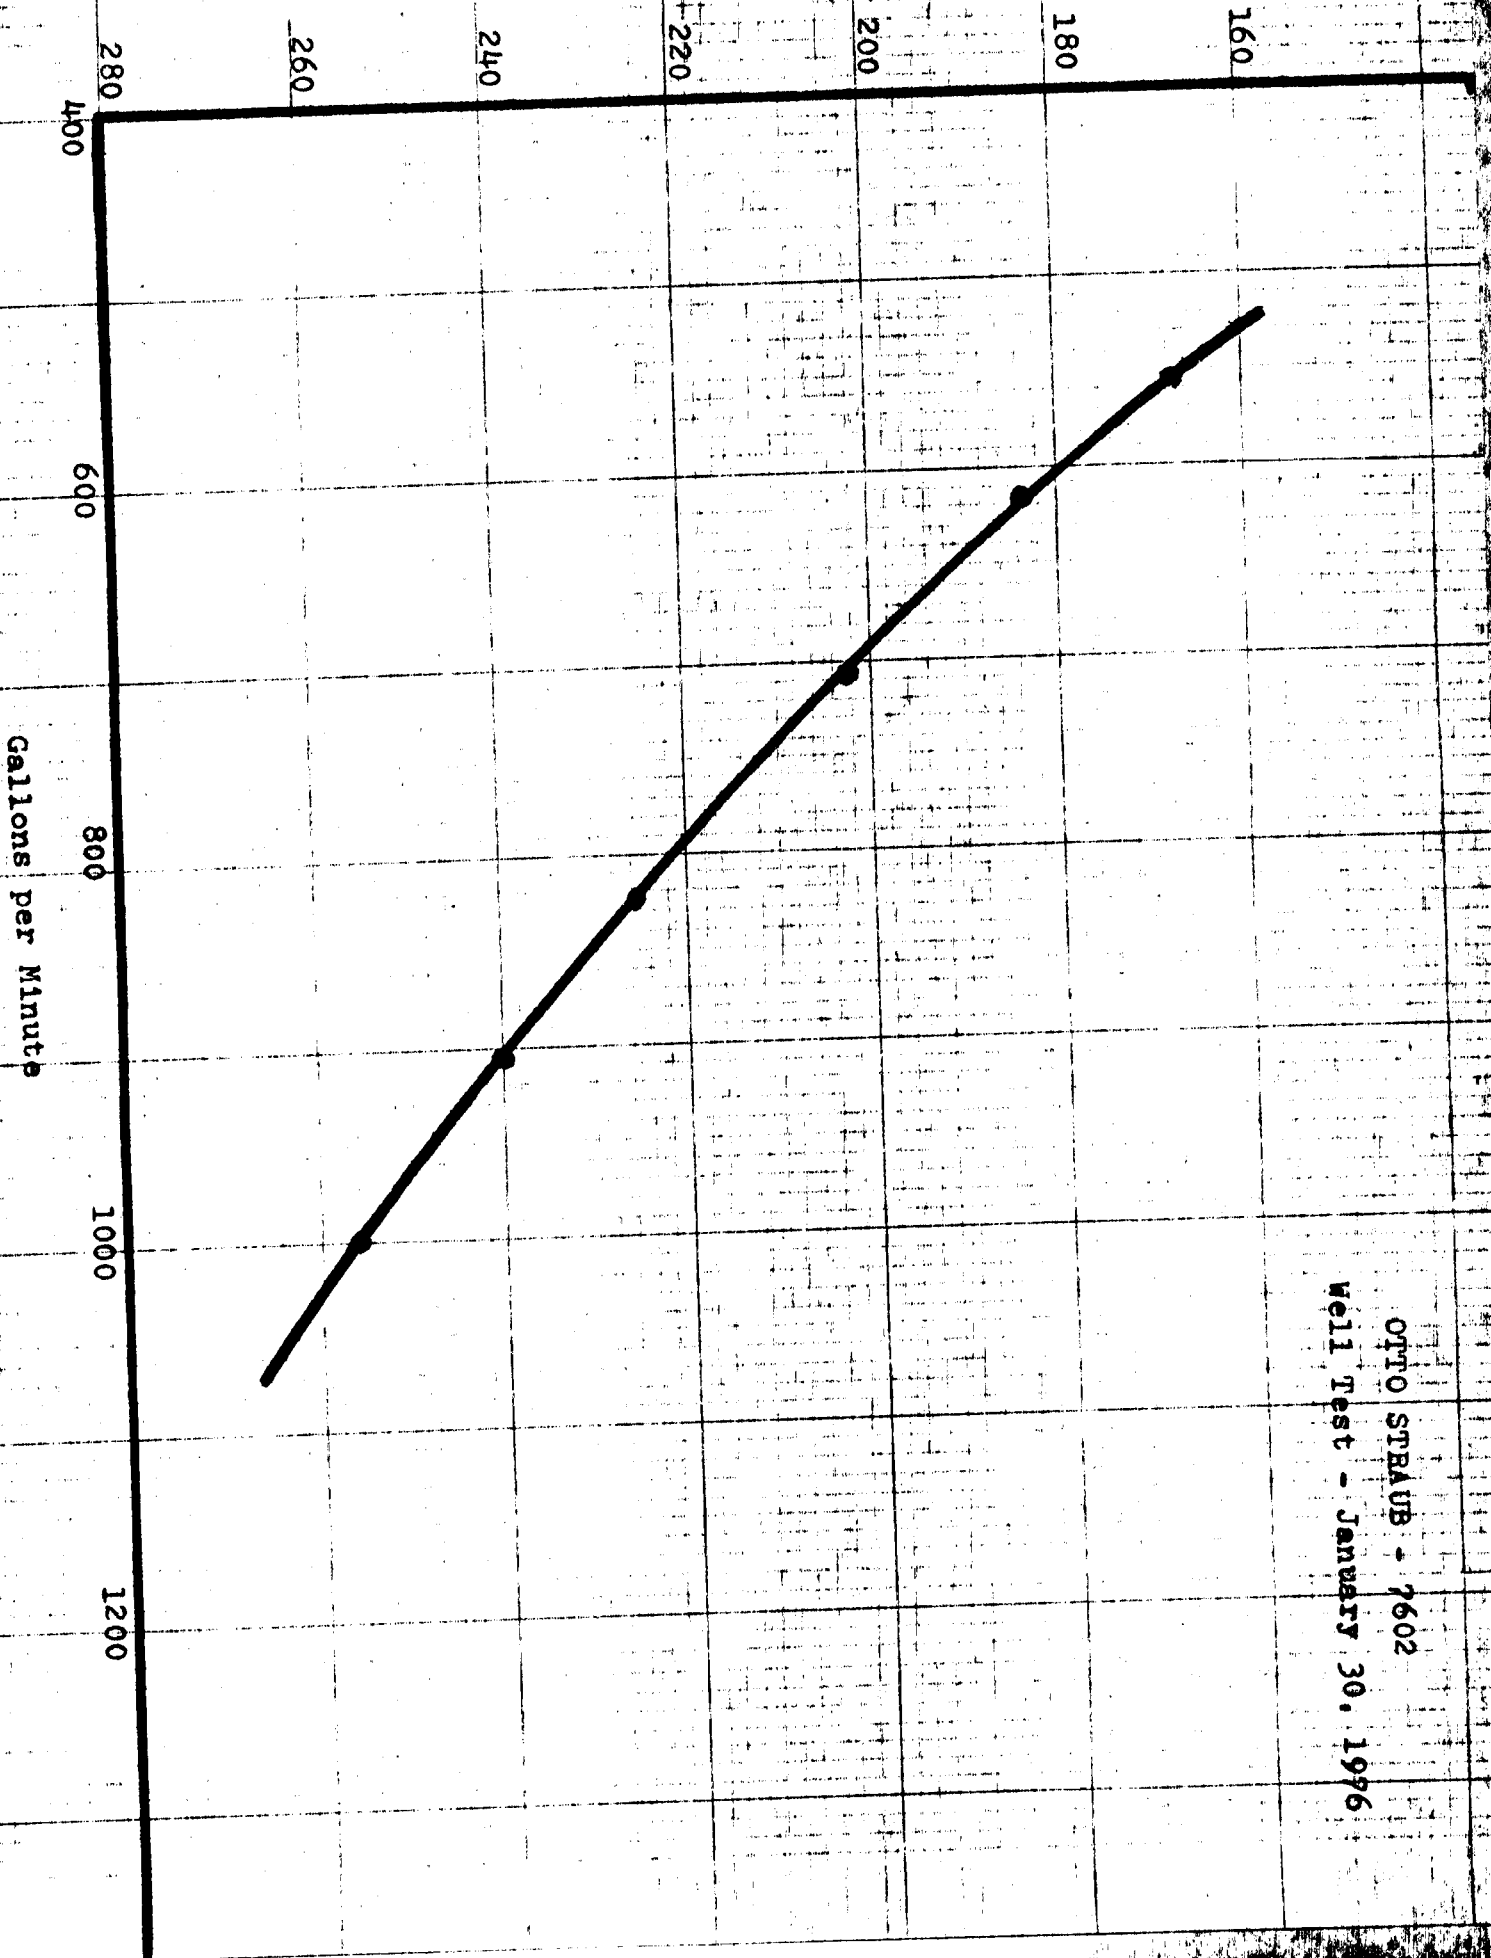

OTTO STRAUB - 7602
Well Test - January 30, 1976