

STATE ENGINEER
Salem, Oregon

CLAC
02387

Well Record


STATE WELL NO. 5/1-7M
COUNTY Clackamas
APPLICATION NO. GR-4262

OWNER: Curtis Nelson MAILING ADDRESS: Route 1, Box 183

LOCATION OF WELL: Owner's No. CITY AND STATE: Hubbard, Oregon

NW ¼ SW ¼ Sec. 7 T. 5 S., R. 1 E. W., W.M.

Bearing and distance from section or subdivision corner South 18° East 3635 feet from the NW Corner, Section 7.

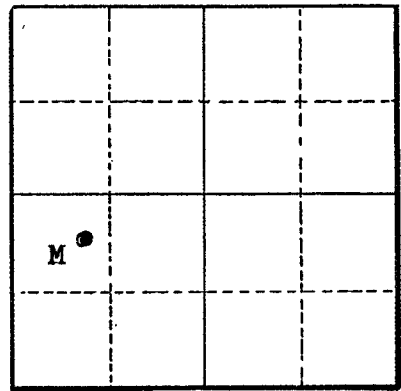

Section 7

Altitude at well 175 feet

TYPE OF WELL: Drilled Date Constructed Sept, 1946

Depth drilled 124 feet Depth cased 124 feet

CASING RECORD:

6-inch steel casing set from surface to 124 feet

FINISH:

perforated - 3/8 by 1/2" - 15 per ft. from 103 to 120 feet

AQUIFERS:

WATER LEVEL:
35 feet

PUMPING EQUIPMENT: Type Peerless-Electric H.P. _____
Capacity 140 G.P.M.

WELL TESTS:
Drawdown 65 ft. after _____ hours 50 G.P.M.
Drawdown 96 ft. after _____ hours 148 G.P.M.

USE OF WATER Irrigation Temp. _____ °F. _____, 19____

SOURCE OF INFORMATION GR-4113
DRILLER or DIGGER J. W. Beck, Canby, Oregon

ADDITIONAL DATA:
Log (NA) Water Level Measurements _____ Chemical Analysis _____ Aquifer Test _____

REMARKS: