

STATE ENGINEER
Salem, Oregon

CLAC
02388

Well Record

6-6515

STATE WELL NO. 5/1-7N(1)
COUNTY Clackamas
APPLICATION NO. GR-614

OWNER: Elmer & Nancy Glick


MAILING ADDRESS: Route 1, Box 184

LOCATION OF WELL: Owner's No.

CITY AND STATE: Hubbard, Oregon

SW 1/4 SW 1/4 Sec. 7 T. 5 S., R. 1 W., W.M.

Bearing and distance from section or subdivision corner 1300' N. & 900' E. from SW cor. Sec. 7

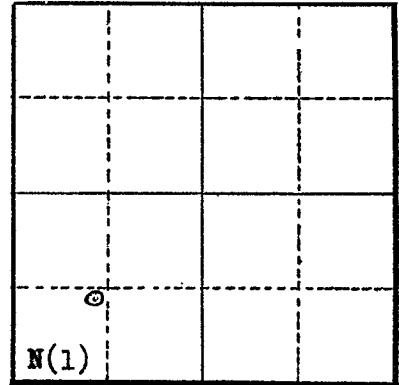

Altitude at well 175 feet Interpolated

TYPE OF WELL: Drilled Date Constructed 10-19-50

Depth drilled 125 Depth cased 125

Section 7

CASING RECORD:

8 inch

FINISH:

AQUIFERS:

WATER LEVEL:

28 feet

PUMPING EQUIPMENT: Type Turbine H.P. 7 1/2
Capacity 256 G.P.M.

WELL TESTS:

Drawdown 40 ft. after 280 hours G.P.M.
Drawdown ft. after hours G.P.M.

USE OF WATER Irrigation 53 acres Temp. °F. 19

SOURCE OF INFORMATION GR-614

DRILLER or DIGGER J. W. Beck

ADDITIONAL DATA:

Log No. Water Level Measurements Chemical Analysis Aquifer Test

REMARKS:

Gravel 58 to 80 feet and 110 to 123 feet