

STATE ENGINEER
Salem, Oregon

Well Record
02428
CLAC

STATE WELL NO. 5/1-9C
COUNTY CLACKAMAS
APPLICATION NO. GR-2769

OWNER: Mrs. Homer Khopp


MAILING ADDRESS: Rt. 1, Box 127 A

LOCATION OF WELL: Owner's No.

CITY AND STATE: Hubbard, Oregon

NE 1/4 NW 1/4 Sec. 9 T. 5 N. 1 E. S., R. 1 W., W.M.

Bearing and distance from section or subdivision corner 72' W. and 275' S.

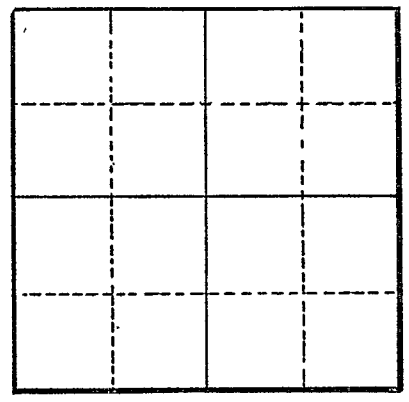

Section

Altitude at well

TYPE OF WELL: drilled Date Constructed 1953

Depth drilled 49 Depth cased 49

CASING RECORD:

6-inch

FINISH:

AQUIFERS:

Soil, sand, clay and rock

WATER LEVEL:
16-feet

PUMPING EQUIPMENT: Type Jet pump H.P. 1/2
Capacity 12 G.P.M.

WELL TESTS:
Drawdown 45 ft. after hours Pumping 28 G.P.M.
Drawdown ft. after hours G.P.M.

USE OF WATER irrigation Temp. °F. 19

SOURCE OF INFORMATION GR-2618

DRILLER or DIGGER

ADDITIONAL DATA:
Log Water Level Measurements Chemical Analysis Aquifer Test

REMARKS:

Soil	15	15
Sand	8	23
Blue clay	16	39
Rock	6	45
Black sand	4	49