

STATE ENGINEER
Salem, Oregon

CLAC
02448

Well Record

GR- 1625

STATE WELL NO. 5/1-10N
COUNTY Clackamas
APPLICATION NO. GR- 1675

OWNER: Walter Olson

MAILING
ADDRESS: Rt. 1

LOCATION OF WELL: Owner's No.

CITY AND
STATE: Hubbard, Oregon

SW $\frac{1}{4}$ SW $\frac{1}{4}$ Sec. 10 T. 5 S., R. 1 E. W.M.

Bearing and distance from section or subdivision

corner 300' N. & 300' E. from SW cor. Sec. 10


Altitude at well

TYPE OF WELL: Drilled Date Constructed 1947

Depth drilled 165' Depth cased 150'

CASING RECORD:

8"

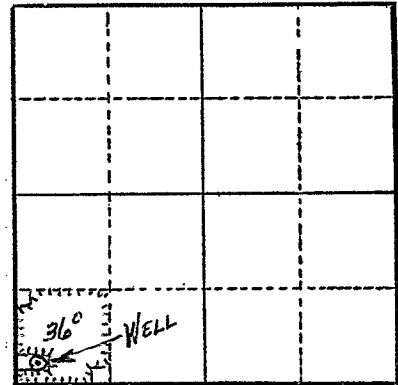

Section 10

FINISH:

AQUIFERS:

Sand & gravel

WATER LEVEL:

50'

PUMPING EQUIPMENT: Type Cook turbine

H.P. 5

Capacity 70 G.P.M.

WELL TESTS:

Drawdown ft. after hours G.P.M.

Drawdown ft. after hours G.P.M.

USE OF WATER Irrigation Temp. °F., 19

SOURCE OF INFORMATION GR Record

DRILLER or DIGGER Miller

ADDITIONAL DATA:

Log N.A. Water Level Measurements Chemical Analysis Aquifer Test

REMARKS:

Irrigation of 36 acres.