

STATE ENGINEER
Salem, Oregon

CLAC
02468

Well Record

STATE WELL NO. 5/1-11M
COUNTY Clackamas
APPLICATION NO. GR-1559

GR- 1503

OWNER: Nels Sanden


MAILING ADDRESS: Rt. 2

LOCATION OF WELL: Owner's No.

CITY AND STATE: Canby, Oregon

NW 1/4 SW 1/4 Sec. 11 T. 5 S., R. 17 W.M.

Bearing and distance from section or subdivision corner 1600' N. & 750' E. from SW cor. Sec. 11

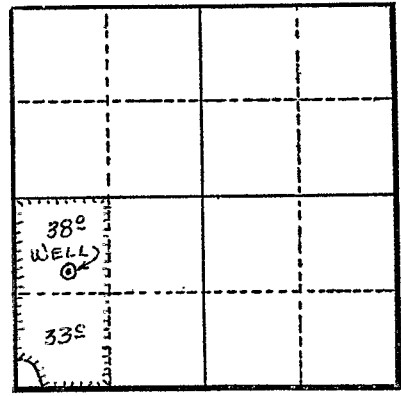

Altitude at well 284'

TYPE OF WELL: Drilled Date Constructed 1946

Depth drilled 465' Depth cased 460'

Section 11

CASING RECORD:

12" from 0 to 200 ft.
10" from 200 to 460 ft.

FINISH:

Perforated with 4 rows (3/4" x 8")

AQUIFERS:

WATER LEVEL:

35'

PUMPING EQUIPMENT: Type Lane & Bowler turbine H.P. 50
Capacity 600 G.P.M.

WELL TESTS:

Drawdown 130 ft. after 600 hours G.P.M.
Drawdown ft. after hours G.P.M.

USE OF WATER Irrigation Temp. °F. 19

SOURCE OF INFORMATION GR Record

DRILLER or DIGGER

ADDITIONAL DATA:

Log N.A. Water Level Measurements Chemical Analysis Aquifer Test

REMARKS:

Irrigation of 71 acres.



Oregon Water Resources Department
 725 Summer Street NE, Suite A
 Salem Oregon 97301
 (503) 986-0900
 www.oregon.gov/owrd

Application for Well ID Number

RECEIVED

MAY 2 2024

Do not complete if the well already has a Well Identification Number.

OWRD

I. OWNER INFORMATION

Current Owner Name (please print): Willamette Egg Farms
 Mailing Address: 31348 S Highway 170
 City, State, Zip: Canby, OR 97013
 Mail Well ID to: SAME AS ABOVE In Care Of (C/O)
 Name & Address: _____
 City, State, Zip: _____

II. WELL LOCATION INFORMATION (Please fill out as completely as possible)

Township: 55 (North/South) Range: 1E (East/West) Section: 11 NW 1/4 of the SW 1/4
 Tax Lot (usually last 3-5 numbers of Tax Map #): 702 County Clatsop
 GPS Coordinates: 45.147840 -122.658060
 Street Address of Well, City: 10010 S. HWY 211 Canby, OR 97013
 If the property had a different street address in the past: _____

III. GENERAL WELL INFORMATION (Please fill out as completely as possible. AND attach copy of Well Report, if available)

Use of Well (domestic, irrigation, commercial, industrial, monitoring): ?
 Date Well Constructed (or property built): 1946 Total Well Depth: 465' Casing Diameter: 12"
 Owner at time the well was constructed (if known): Nels Sanden Well Report # (if known): CLAC 2468
 Other Information: Well #3 Satrum Layers

SUBMITTED BY (please print): Emily Sahagun
 PHONE: 916-473-3457 EMAIL &/or FAX: esahagun@willametteeggfarms.com

To send the completed application, you may MAIL it to: Oregon Water Resources Dept. 725 Summer St NE, Suite A, Salem, Oregon 97301.
 Or EMAIL the completed PDF form to: Ladeena.K.Ashley@water.oregon.gov, or FAX it to: (503) 986-0902.

For Official Use Only by the Oregon Water Resources Department:

Received Date:
5-2-2024

Well Report Number:
CLAC 2468

Well Identification #:
L-154720