

STATE ENGINEER
Salem, Oregon

CLAC Well Record
02528

STATE WELL NO. 5/1-16K
COUNTY Clackamas
APPLICATION NO. GR-902

OWNER: Randolph M Carlson

MAILING

ADDRESS: Route 1, Box 157

LOCATION OF WELL: Owner's No.


CITY AND

STATE: Hubbard, Oregon

NW 1/4 SE 1/4 Sec. 16 T. 5 N. S. R. 1 W., W.M.

Bearing and distance from section or subdivision

corner 1440' W. & 300' S. from E 1/4 cor. Sec. 16

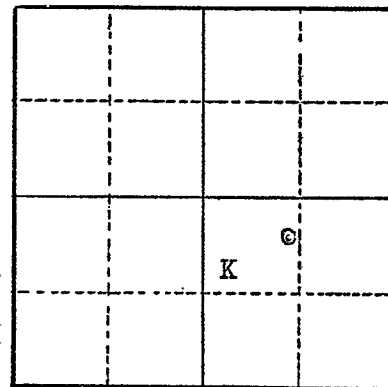

Section 16

Altitude at well 235

TYPE OF WELL: drilled Date Constructed Oct. '50

Depth drilled 219 Depth cased 200

CASING RECORD:

6 inch steel 0 to 200 feet

FINISH:

Mills knife perforations 85 to 98'
190 to 200'

AQUIFERS:

Black sand water bearing at 25 - 90 - 190'

WATER LEVEL:

25

PUMPING EQUIPMENT: Type Peerless H.P. 5 Elec. GE
Capacity 70 G.P.M.

WELL TESTS:

Drawdown 78 ft. after 50 hours G.P.M.

Drawdown 76 ft. after 100 hours G.P.M.

USE OF WATER Irrigation Temp. °F. May, 1951

SOURCE OF INFORMATION Owner

DRILLER or DIGGER Johnnie Beck, Canby

ADDITIONAL DATA:

Log NA Water Level Measurements Chemical Analysis Aquifer Test

REMARKS: