

STATE ENGINEER
Salem, Oregon

CLAC
02529 Well Record

STATE WELL NO. 5/1-16M
COUNTY Marion
APPLICATION NO. GR-4190

OWNER: Allen Kropf & Eloise Kropf

MAILING

ADDRESS: Route 1, Box 161

LOCATION OF WELL: Owner's No.


CITY AND

STATE: Hubbard, Oregon

NW ¼ SW ¼ Sec. 16 T. 5 S., R. 1 W., W.M.

Bearing and distance from section or subdivision

corner 940' E. & 100' S. of W¹/₄ Cor. Sec. 16

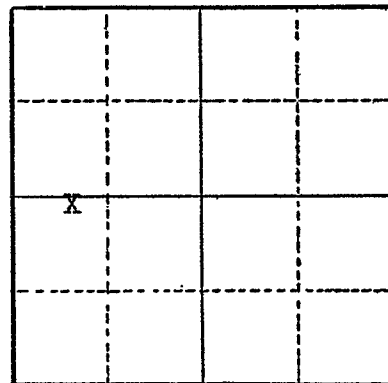

Altitude at well

TYPE OF WELL: Drilled Date Constructed 6/52

Depth drilled 148 ft. Depth cased 143 ft.

Section 16

CASING RECORD:

6 inch casing set to 143 feet

FINISH:

AQUIFERS:

WATER LEVEL:

23 feet below surface

PUMPING EQUIPMENT: Type Sumo H.P.
Capacity G.P.M.

WELL TESTS:

Drawdown ft. after hours G.P.M.

Drawdown ft. after hours G.P.M.

USE OF WATER Irrigation Temp. °F., 19

SOURCE OF INFORMATION Well Registration Statement Cert. # GR-3747

DRILLER or DIGGER John Beck

ADDITIONAL DATA:

Log Water Level Measurements Chemical Analysis Aquifer Test

REMARKS: