

STATE ENGINEER
Salem, Oregon

CLAC
02530

Well Record

STATE WELL NO. 5/1-16R
COUNTY Clackamas
APPLICATION NO. GR-4197

OWNER: Fay O. Huiras

MAILING
ADDRESS:

Route 3, Box 274

LOCATION OF WELL: Owner's No.

CITY AND
STATE:

Molalla, Oregon

SE 1/4 SE 1/4 Sec. 16 T. 5 S. R. 1 E. W.M.


Bearing and distance from section or subdivision

corner 300' N. & 114' W. from SE Cor. Sec. 16

Altitude at well

TYPE OF WELL: Drilled Date Constructed 6/21/53

Depth drilled 150 ft. Depth cased 150 ft.

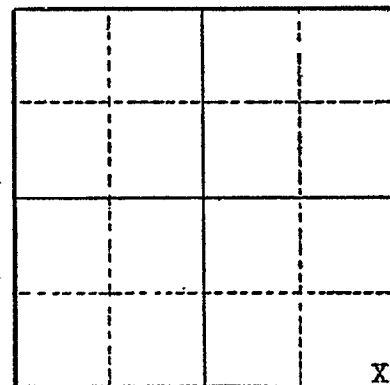

Section 16

CASING RECORD:

6 inch I.D. set to 150 feet

FINISH:

AQUIFERS:

WATER LEVEL:

60 feet below surface

PUMPING EQUIPMENT: Type Sumo H.P. 3.6
Capacity 45.7 G.P.M.

WELL TESTS:

Drawdown ft. after hours G.P.M.

Drawdown ft. after hours G.P.M.

USE OF WATER Irrigation Temp. °F., 19

SOURCE OF INFORMATION Well Registration Statement Cert. # GR-3750

DRILLER or DIGGER J. W. Beck, Canby, Oregon

ADDITIONAL DATA:

Log Water Level Measurements Chemical Analysis Aquifer Test

REMARKS: