

STATE ENGINEER  
Salem, Oregon

02565  
CLAC

# Well Record

STATE WELL NO. 5/1-18L  
COUNTY Clackamas  
APPLICATION NO. GR-1558

GR- 1502

OWNER: Elmer H. Schneider


MAILING ADDRESS: Rt. 2, Box 171

LOCATION OF WELL: Owner's No.

CITY AND STATE: Woodburn, Oregon

NE 1/4 SW 1/4 Sec. 18 T. 5 S., R. 1 E. W.M.

Bearing and distance from section or subdivision corner 100' S. & 100' W. from Center of Sec. 18

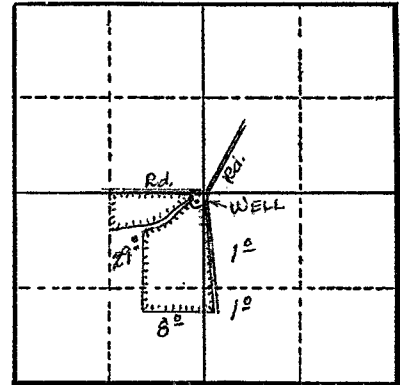

Section 18

Altitude at well

TYPE OF WELL: Drilled Date Constructed 1942

Depth drilled 72' Depth cased 72'

CASING RECORD:  
8"

FINISH:

AQUIFERS:

WATER LEVEL:

Flowing

PUMPING EQUIPMENT: Type Peerless turbine H.P. 5  
Capacity 90 G.P.M.

WELL TESTS:

Drawdown ft. after hours G.P.M.  
Drawdown ft. after hours G.P.M.

USE OF WATER Irrigation Temp. °F., 19

SOURCE OF INFORMATION GR Record

DRILLER or DIGGER B. F. Ballweber

ADDITIONAL DATA:

Log N.A. Water Level Measurements Chemical Analysis Aquifer Test

REMARKS:

Irrigation of 39 acres.

Measured discharge of 20 GPM on 2/15/56