

STATE ENGINEER
Salem, Oregon

CLAC Well Record
02822

STATE WELL NO. 5/1-23G
COUNTY CLACKAMAS
APPLICATION NO. GR-2909

OWNER: Crestview Farms


MAILING ADDRESS: Rt. 3, Box 362

LOCATION OF WELL: Owner's No.

CITY AND STATE: Molalla, Oregon

SW 1/4 NE 1/4 Sec. 23 T. 5 N. S, R. 1 E. W.M.

Bearing and distance from section or subdivision corner S. 48° W. 3145'

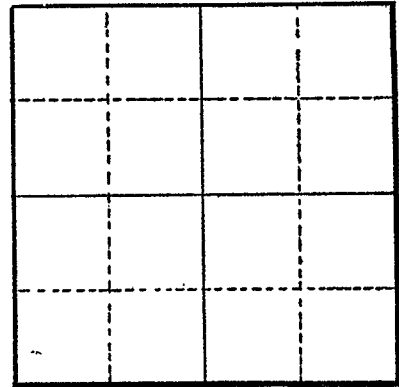

Section

Altitude at well

TYPE OF WELL: drilled Date Constructed 1954

Depth drilled 219 Depth cased 210

CASING RECORD:

6-inch

FINISH:

AQUIFERS:

Clay, sand and gravel

WATER LEVEL:

40-feet

PUMPING EQUIPMENT: Type Sumo submersible H.P. 7 1/2

Capacity 60 G.P.M.

WELL TESTS:

Drawdown 150 ft. after Pumping 60 hours G.P.M.

Drawdown ft. after hours G.P.M.

USE OF WATER irrigation Temp. °F., 19

SOURCE OF INFORMATION GR-2738

DRILLER or DIGGER John Beck, Canby, Oregon

ADDITIONAL DATA:

Log X Water Level Measurements Chemical Analysis Aquifer Test

REMARKS:

Clay 210 210
Sand and gravel 9 219