

STATE ENGINEER
Salem, Oregon

CLAC Well Record
02623

STATE WELL NO. 5/1-23B
COUNTY CLACKAMAS
APPLICATION NO. GR-2910

OWNER: Crestview Farms


MAILING ADDRESS: Rt. 3, Box 362

LOCATION OF WELL: Owner's No. _____

CITY AND STATE: Molalla, Oregon

NW 1/4 NE 1/4 Sec. 23 T. 5 S., R. 1 E., W.M.

Bearing and distance from section or subdivision corner S. 77° 30' W. 2385'

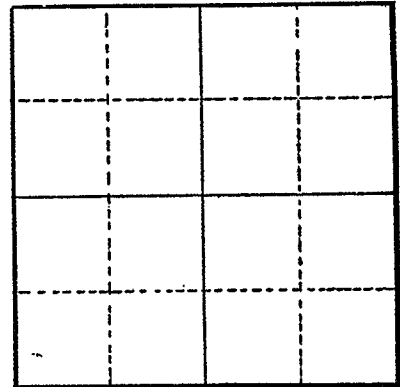

Section _____

Altitude at well _____

TYPE OF WELL: drilled Date Constructed 1954

Depth drilled 419 Depth cased 320

CASING RECORD:

6-inch

FINISH:

Handwritten notes:
No. 1, 2, 3, 4, 5
to well, 2000
feet

AQUIFERS:

Clay, sand, gravel and rock

WATER LEVEL:
80-feet

PUMPING EQUIPMENT: Type Jacuzzi Turbine H.P. 25
Capacity 200 G.P.M.

WELL TESTS:
Drawdown 120 ft. after _____ hours Pumping 200 G.P.M.
Drawdown _____ ft. after _____ hours _____ G.P.M.

USE OF WATER Irrigation Temp. _____ °F. _____, 19____

SOURCE OF INFORMATION GR-2739
DRILLER or DIGGER John Beck, Canby, Oregon

ADDITIONAL DATA:
Log X Water Level Measurements _____ Chemical Analysis _____ Aquifer Test _____

REMARKS:

Clay 280 280
Sand & gravel 280 282
Clay 282 320
Basalt rock 320 420