

STATE ENGINEER
Salem, Oregon


02667 Well Record

CLAC

STATE WELL NO. 5/1-27B
COUNTY Clackamas
APPLICATION NO. GR-3668

OWNER: Cecil E. Judd or Latha E. Judd
MAILING ADDRESS: Route 3 Box 291
CITY AND STATE: Molalla, Oregon

LOCATION OF WELL: Owner's No. _____
NW 1/4 NE 1/4 Sec. 27 T. 5 S., R. 1 E., W.M.
Bearing and distance from section or subdivision
corner 2 1/2 ch. S. and 42 ch. E. of NW cor. Sec. 27

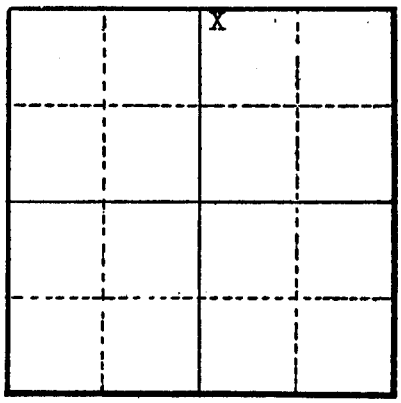

Altitude at well _____
TYPE OF WELL: Drilled Date Constructed May, 1951
Depth drilled 320 ft. Depth cased 320 ft.

Section 27

CASING RECORD:

6 inch steel well casing set from 0 to 280 feet
6 inch through solid rock set from 280 to 320 feet

FINISH:

No perforations

AQUIFERS:

WATER LEVEL:

27 feet below surface

PUMPING EQUIPMENT: Type Deming Working Head H.P. 3/4
Capacity 10 G.P.M.

WELL TESTS:

Drawdown 85 ft. after _____ hours 75 G.P.M.
Drawdown _____ ft. after _____ hours _____ G.P.M.

USE OF WATER Irrigation Temp. _____ °F., 19

SOURCE OF INFORMATION Well Registration Statement
DRILLER or DIGGER John Beck

ADDITIONAL DATA:

Log _____ Water Level Measurements _____ Chemical Analysis _____ Aquifer Test _____

REMARKS:

3364