

STATE ENGINEER
Salem, Oregon

CLAC Well Record
02702

STATE WELL NO. 5/1-29P
COUNTY Clackamas
APPLICATION NO. GR-4260

OWNER: Elmer R. Thompson

MAILING

ADDRESS: Route 2, Box 244

LOCATION OF WELL: Owner's No.

CITY AND

STATE: Woodburn, Oregon

SE $\frac{1}{4}$ SW $\frac{1}{4}$ Sec. 29 T. 5 N. S. R. 1 E. W.M.

Bearing and distance from section or subdivision


corner North 57°30' East 372 feet from SW

Corner of SE $\frac{1}{4}$

Altitude at well 280 feet

TYPE OF WELL: Drilled Date Constructed 6-21-46

Depth drilled 144 feet Depth cased 144 feet

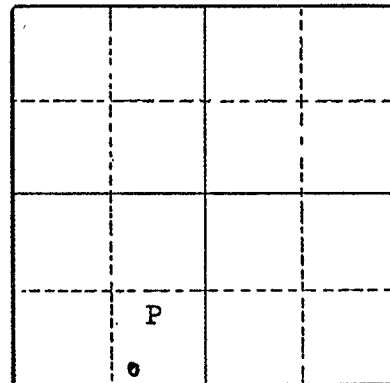

Section 29

CASING RECORD:

6-inch casing set from 0 to 144 feet

FINISH:

AQUIFERS:

clay

WATER LEVEL:

67 feet

PUMPING EQUIPMENT: Type Cook Pump

H.P.

Capacity 125 G.P.M.

WELL TESTS:

Drawdown 72 ft. after 96 hours G.P.M.

Drawdown 72 ft. after 96 hours G.P.M.

USE OF WATER Irrigation

Temp. °F. 19

SOURCE OF INFORMATION GR-4109

DRILLER or DIGGER

ADDITIONAL DATA:

Log ☒ Water Level Measurements Chemical Analysis Aquifer Test

REMARKS:

The first 3 feet soil is Willamette soil then the next 20 feet is light clay then it goes into a bluish clay soil with pebbles.

The balance reems sand and clay with gravel pebbles. We struck a few rocks at 3 to 4" size with clay parts in soil.

RECEIVED
For Official Use Only by The Oregon Water Resources Department:

Received Date:

FEB 20 2004

County Well Log ID #

CLAC 2702

Well Identification Tag #

L-70265

WATER RESOURCES DEPT.
SALEM, OREGON

WELL IDENTIFICATION APPLICATION FORM

INSTRUCTIONS ARE IN THE ACCOMPANYING "DEAR LANDOWNER" LETTER. FOR SHARED WELLS PLEASE SEE THE 3RD PARAGRAPH FROM THE TOP IN THE LETTER. Your ID Tag will be mailed out in approximately 10 days from the date we receive your application.)

****BUYER OR CURRENT LANDOWNER** (For the property that the well is located on. The Well ID tag will be sent to this address unless otherwise specified here.)

Landowner's or Buyer's Name: DON ROTH, LLCMailing Address: 14477 Euans Valley RdCity: SILVERTON State: OR Zip: 97381 Phone: 503 873-8618

**WELL LOCATION:

County: Clackamas Well # _____ (if multiple wells exist on same property-ie: well #1, #2, etc.)Township: 5 North or South (circle one) Range: 1 East or West (circle one) Section: 29 1/4 1/4 (If known)Tax Lot #: 1002 Type of Well: water supply? D monitoring? NO
(Not the same as the tax acct. #) (Ex: domestic or irrigation use) (Ex: monitoring water for contaminants)Address of Well: 7345 MONTE CRISTO WOODBURN
(Number) (Street) (City) (Zip)(Optional): Does this well have a formal water right associated with it? Yes: _____ No: X
(If unknown you may want to contact the Water Rights Group at 503-986-0945 for research)

If Yes: Application #: _____ Permit #: _____ Certificate #: _____

(Optional): Latitude _____ Longitude _____ (May sometimes be obtained from Well Log Report)

****WELL INFORMATION:** (Important note: If attaching a well log you obtained from our web-site please be certain that you have the correct log. Simply matching the tax lot number isn't enough. See attached instructions for assistance. If a well report is not available please complete as much of the following as possible, at a minimum the prior landowner names going back until around the time the well would have been drilled. Prior landowner names can be obtained from the County Assessor - see instructions.)

Start Card # from well log report if known: _____ Approx. Well Construction Date: 1944

Well Constructor if known: _____

Name of Land Owner at Time of Construction (or prior landowners, going back in time to when well was constructed - contact your county assessor for list)

Elmer THOMPSON

Well Depth (in feet): _____ Static Water Level (in feet): _____ Diameter of Exposed Well Casing (in inches): _____

Please Return Completed Form to: Well ID Program, Oregon Water Resources Department
725 Summer St. NE, Suite A, Salem, OR 97301-1271, or fax to 503-986-0902 (App10-03)