

STATE ENGINEER
Salem, Oregon

02713 Well Record
CLAC


STATE WELL NO. 5/1-30B
COUNTY Clackamas
APPLICATION NO. GR-899

OWNER: August E. Rabe
MAILING ADDRESS: Route 2, Box 195 A

LOCATION OF WELL: Owner's No. 1
CITY AND STATE: Woodburn, Oregon

NW 1/4 NE 1/4 Sec. 30 T. 5 N. S. R. 1 E. W., W.M.

Bearing and distance from section or subdivision corner
Approx. 11 chains S. & 18 chains E. from N1/4 cor. of Sec. 30

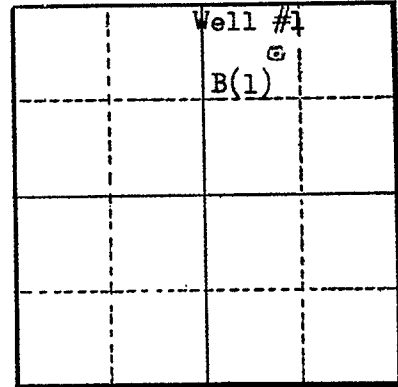

Altitude at well 225

TYPE OF WELL: Drilled Date Constructed Mar. 55

Depth drilled 69 Depth cased 53

Section 30

CASING RECORD:

6 inch standard steel 0 to 53' 4"

FINISH:

Shoe depth 53' 4"

AQUIFERS:

Sand 62 to 65 feet

WATER LEVEL:

25

PUMPING EQUIPMENT: Type Peerless 6B H.P. 5 Elec. GE
Capacity 75 G.P.M.

WELL TESTS:

Drawdown 41 ft. after 110 hours G.P.M.
Drawdown ft. after hours G.P.M.

USE OF WATER Irrigation Temp. °F. 19

SOURCE OF INFORMATION Owner

DRILLER or DIGGER

ADDITIONAL DATA:
Log Water Level Measurements Chemical Analysis Aquifer Test

REMARKS:

