

STATE ENGINEER
Salem, Oregon

CLAC Well Record
02714

GR- 963

STATE WELL NO. ...5/1-30C(1)
COUNTY ...Clackamas...
APPLICATION NO. ...GR- 995...

OWNER: George E. Bond


MAILING ADDRESS: _____

LOCATION OF WELL: Owner's No. #1

CITY AND STATE: Woodburn, Oregon

NE 1/4 NW 1/4 Sec. 30 T. 5 S. R. 1 E., W.M.

Bearing and distance from section or subdivision corner 770' S. & 350' W. from N1/4 cor. Sec. 30.

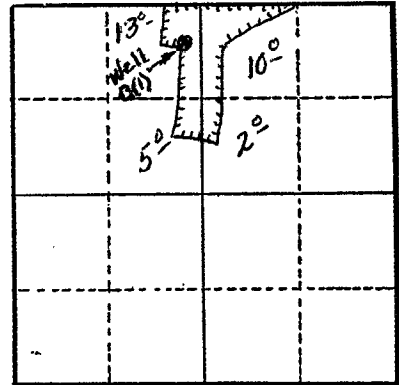

Section 30

Altitude at well 215 ft.

TYPE OF WELL: Drilled Date Constructed 1950

Depth drilled 210 ft. Depth cased 210 ft.

CASING RECORD:

6 inch.

FINISH:

Torch slot perforations from 40 to 210 ft.

AQUIFERS:

WATER LEVEL:

PUMPING EQUIPMENT: Type Peerless Turbine H.P. 7 1/2
Capacity 120 G.P.M.

WELL TESTS:
Drawdown 108 ft. after _____ hours 110 G.P.M.
Drawdown _____ ft. after _____ hours _____ G.P.M.

USE OF WATER Irrigation Temp. _____ °F. _____, 19____

SOURCE OF INFORMATION G.R. Record

DRILLER or DIGGER J. T. Miller

ADDITIONAL DATA:

Log N.A. Water Level Measurements _____ Chemical Analysis _____ Aquifer Test _____

REMARKS:

Irrigation of 30 acres.