

STATE ENGINEER  
Salem, Oregon

02726  
CLAC

# Well Record

STATE WELL NO. 5/1-30R(1)  
COUNTY Clackamas  
APPLICATION NO. GR-74

OWNER: R. L. or Marie Simmons


MAILING ADDRESS: Route 2, Box 204

LOCATION OF WELL: Owner's No. #1

CITY AND STATE: Woodburn, Oregon

SE 1/4 SE 1/4 Sec. 30 T. 5 N. S., R. 1 E, W.M.

Bearing and distance from section or subdivision  
corner 16 chains N. & 3 chains W. from SE cor.  
Sec. 30

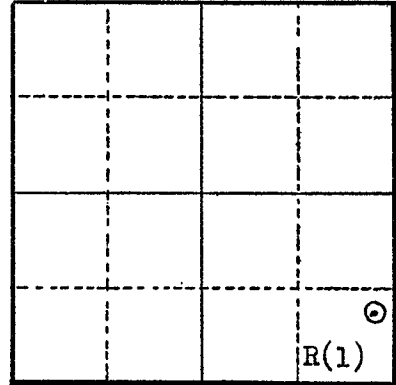

Section 30

Altitude at well 220' Interpolated

TYPE OF WELL: Drilled Date Constructed June 48

Depth drilled 200' Depth cased 190'

### CASING RECORD:

6 inch casing set from 0 to 190 feet

### FINISH:

None

### AQUIFERS:

Unknown

### WATER LEVEL:

70 feet below land surface 7/1948

PUMPING EQUIPMENT: Type Cook turbine H.P. 5

Capacity 70 G.P.M.

### WELL TESTS:

Drawdown 20 ft. after 70 hours G.P.M.

Drawdown ft. after hours G.P.M.

USE OF WATER Irrigation 30 acres Temp. °F., 19

SOURCE OF INFORMATION Registration Statement GR-74

DRILLER or DIGGER Byron Ballweber Route 2, Woodburn, Oregon

### ADDITIONAL DATA:

Log No Water Level Measurements Chemical Analysis Aquifer Test

### REMARKS: