

STATE ENGINEER
Salem, Oregon

CLAC Well Record
02745

STATE WELL NO. 5/1E-32D
COUNTY Clackamas
APPLICATION NO. GR-3283

OWNER: Oscar Gragerson

MAILING

ADDRESS: Route 2, Box 246

LOCATION OF WELL: Owner's No.


CITY AND

STATE: Woodburn, Oregon

NW 1/4 NW 1/4 Sec. 32 T. 5 S. R. 1 E. W.M.

Bearing and distance from section or subdivision

corner 424' S. & 606' W. from NE cor. of NW 1/4 NW 1/4

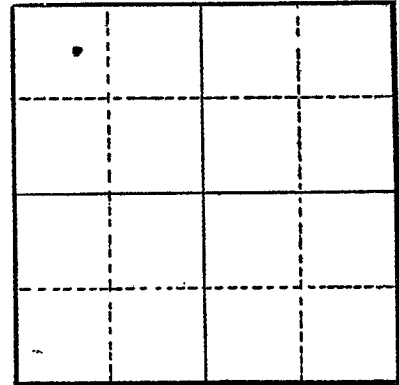

Section

Altitude at well

TYPE OF WELL: Drilled Date Constructed 1951

Depth drilled 150 Depth cased 150

CASING RECORD:

6 inch

FINISH:

AQUIFERS:

WATER LEVEL:

90 feet

PUMPING EQUIPMENT: Type Pomona Turbine H.P. 3
Capacity 30 G.P.M.

WELL TESTS:

Drawdown ft. after hours G.P.M.
Drawdown ft. after hours G.P.M.

USE OF WATER Irrigation Temp. °F., 19

SOURCE OF INFORMATION GR-3052

DRILLER or DIGGER Byron Ballweber, Rt. 2, Woodburn, Oregon

ADDITIONAL DATA:

Log Water Level Measurements Chemical Analysis Aquifer Test

REMARKS: