

STATE ENGINEER
Salem, Oregon

Well Record

STATE WELL NO. 2/1-41
COUNTY CLACKAMAS
APPLICATION NO. GR-2677

CLAC 02978

OWNER: James B. Jones


MAILING ADDRESS: 13701 SW Knaus Road

LOCATION OF WELL: Owner's No. _____

CITY AND STATE: Oswego, Oregon

NE ¹/₄ NE ¹/₄ SW ¹/₄ Sec. 4 T. 2 N. S. R. 1 E. W.M.

Bearing and distance from section or subdivision corner W. 155.33' and S. 91.00'

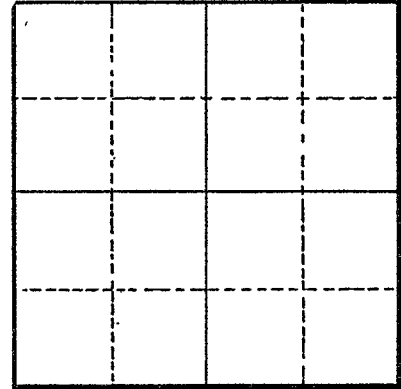

Section _____

Altitude at well _____

TYPE OF WELL: drilled Date Constructed 1946

Depth drilled 235 Depth cased _____

CASING RECORD:

FINISH:

AQUIFERS:

WATER LEVEL:

175-feet

PUMPING EQUIPMENT: Type Peerless Deep well H.P. 3
Capacity 12 G.P.M.

WELL TESTS:

Drawdown _____ ft. after _____ hours _____ G.P.M.
Drawdown _____ ft. after _____ hours _____ G.P.M.

USE OF WATER irrigation Temp. _____ °F. _____, 19_____

SOURCE OF INFORMATION GR-2535

DRILLER or DIGGER Steinman Brothers Drilling Co., 15112 SE McLoughlin Blvd., Portland, Oregon

ADDITIONAL DATA:

Log _____ Water Level Measurements _____ Chemical Analysis _____ Aquifer Test _____

REMARKS: