

STATE ENGINEER
Salem, Oregon

CLAC
03026

Well Record

STATE WELL NO. 2/1-8M
COUNTY Clackamas
APPLICATION NO. GR-1921

OWNER: Thomas Babbs


MAILING ADDRESS: Rt. 1, Box 637

LOCATION OF WELL: Owner's No.

CITY AND STATE: Lake Grove, Oregon

NW 1/4 SW 1/4 Sec. 8 T. 2 S., R. 1 E., W.M.

Bearing and distance from section or subdivision corner 100' E and 600' S from W corner

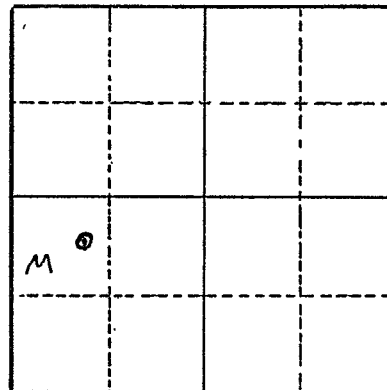

Section 8

Altitude at well

TYPE OF WELL: Drilled Date Constructed 1945

Depth drilled 102' Depth cased 102'

CASING RECORD:

8-inch

FINISH:

screens 24"

AQUIFERS:

clay, compact gravel
solid rock

WATER LEVEL:

NA

PUMPING EQUIPMENT: Type Pacific Jet Pump

H.P. 2

Capacity G.P.M.

WELL TESTS:

Drawdown none ft. after hours 100 G.P.M.

Drawdown ft. after hours G.P.M.

USE OF WATER Irrigation Temp. °F. 19

SOURCE OF INFORMATION GR-3840

DRILLER or DIGGER NA

ADDITIONAL DATA:

Log Water Level Measurements Chemical Analysis Aquifer Test

REMARKS:

