

STATE ENGINEER
Salem, Oregon

CLAC 03032 Well Record

STATE WELL NO. 2/1-9C
COUNTY Clackamas
APPLICATION NO. GR-3968

OWNER: Lake Oswego Water Company

MAILING

ADDRESS: P.O. Box 505

LOCATION OF WELL: Owner's No.


CITY AND

STATE: Oswego, Oregon

NE $\frac{1}{4}$ NW $\frac{1}{4}$ Sec. 9 T. 2 S., R. 1 E., W.M.

Bearing and distance from section or subdivision

corner 430' N. of SW Cor. Albert Durham DIC 44

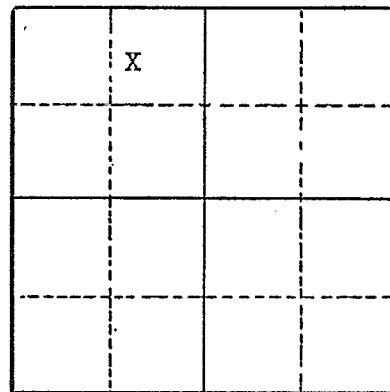

Altitude at well

TYPE OF WELL: Drilled Date Constructed 1946

Depth drilled 490 ft. Depth cased

Section 9

CASING RECORD:

FINISH:

AQUIFERS:

WATER LEVEL:

PUMPING EQUIPMENT: Type Pomona Unidrive turbine
Capacity 250 G.P.M.

H.P. 50

WELL TESTS:

Drawdown ft. after hours G.P.M.

Drawdown ft. after hours G.P.M.

USE OF WATER Municipal Temp. °F. 19

SOURCE OF INFORMATION Well Registration Statement Cert. # GR-3584

DRILLER or DIGGER

ADDITIONAL DATA:

Log Water Level Measurements Chemical Analysis Aquifer Test

REMARKS: