

STATE ENGINEER
Salem, Oregon

CLAC 0303 Well Record

STATE WELL NO. 2/1-9E
COUNTY Clackamas
APPLICATION NO. GR-3967

OWNER: Lake Oswego Water Company

MAILING ADDRESS: P.O. Box 505

LOCATION OF WELL: Owner's No.


CITY AND STATE: Oswego, Oregon

SW $\frac{1}{4}$ NW $\frac{1}{4}$ Sec. 9 T. 2 S., R. 1 E., W.M.

Bearing and distance from section or subdivision

corner N. 15°30' E. 1040' from SW Cor. of NW $\frac{1}{4}$

Sec. 9

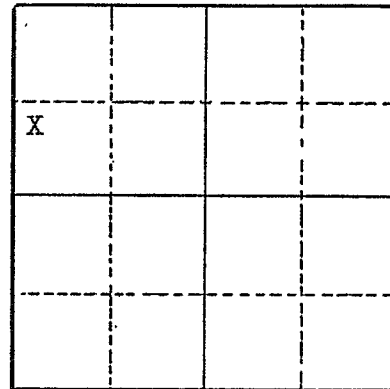

Altitude at well

TYPE OF WELL: Drilled Date Constructed 1928

Depth drilled 200 ft. Depth cased

Section 9

CASING RECORD:

FINISH:

AQUIFERS:

WATER LEVEL:

3 feet below surface

PUMPING EQUIPMENT: Type Pamona Turbine pump
Capacity 135 G.P.M.

H.P. 20

WELL TESTS:

Drawdown ft. after hours G.P.M.

Drawdown ft. after hours G.P.M.

USE OF WATER Municipal

Temp. °F. 19

SOURCE OF INFORMATION Well Registration Statement Cert. # GR-3582

DRILLER or DIGGER

ADDITIONAL DATA:

Log Water Level Measurements Chemical Analysis Aquifer Test

REMARKS: