

STATE ENGINEER
Salem, Oregon

CLAC
03035

Well Record

STATE WELL NO. 2/1-9J
COUNTY Clackamas
APPLICATION NO. GR-3969

OWNER: Lake Oswego Water Company

MAILING ADDRESS: P.O. Box 505

LOCATION OF WELL: Owner's No.


CITY AND STATE: Oswego, Oregon

NE 1/4 SE 1/4 Sec. 9 T. 2 S., R. 1 E. W.M.

Bearing and distance from section or subdivision

corner N. 45°00' E. 290 ft. from SW Cor. Block 4

plat. of Oswego Heights

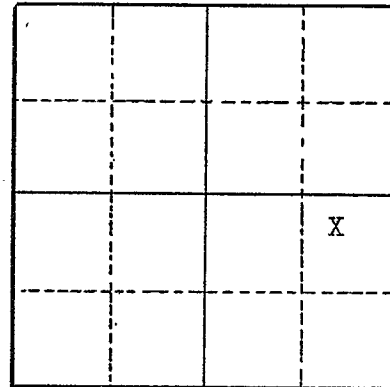

Altitude at well

TYPE OF WELL: Drilled Date Constructed May, 1948

Depth drilled 500 ft. Depth cased

Section 9

CASING RECORD:

FINISH:

AQUIFERS:

WATER LEVEL:

PUMPING EQUIPMENT: Type Pomona Turbine
Capacity 235 G.P.M.

H.P. 50

WELL TESTS:

Drawdown ft. after hours G.P.M.

Drawdown ft. after hours G.P.M.

USE OF WATER Municipal

Temp. °F. 19

SOURCE OF INFORMATION Well Registration Statement Cert. # GR-3585

DRILLER or DIGGER

ADDITIONAL DATA:

Log Water Level Measurements Chemical Analysis Aquifer Test

REMARKS: