

STATE ENGINEER  
Salem, Oregon

CLAC  
03055 Well Record

STATE WELL NO. 2/1-12J  
COUNTY Clackamas  
APPLICATION NO. GR-3393

OWNER: Ambrose Brownell


MAILING ADDRESS: Box 5965

LOCATION OF WELL: Owner's No. Well #1

CITY AND STATE: Milwaukie, Oregon

NE 1/4 SE 1/4 Sec. 12 T. 2 N. 1 E. S., R. 1 W., W.M.

Bearing and distance from section or subdivision corner S. 27°32' E. 101.52' and S. 66°30' W. 30' from the NE COR. of the Stephen Walker DLC

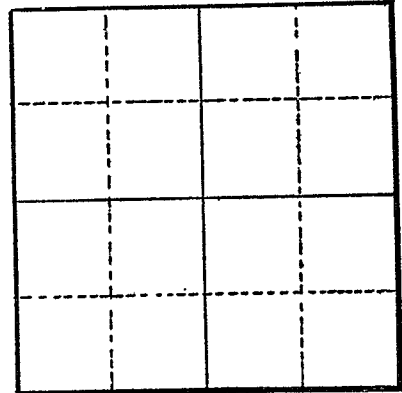

Section .....

Altitude at well .....

TYPE OF WELL: drilled Date Constructed 1932

Depth drilled 235' Depth cased 90'

CASING RECORD:  
8"

FINISH:

AQUIFERS:

WATER LEVEL:  
25'

PUMPING EQUIPMENT: Type Pomona H.P. 5  
Capacity 75 G.P.M.

WELL TESTS:  
Drawdown 120 ft. after pumping 75 hours G.P.M.  
Drawdown ft. after hours G.P.M.

USE OF WATER Irrigation Temp. °F. 19

SOURCE OF INFORMATION GR-3132  

ADDITIONAL DATA:  
Log Water Level Measurements Chemical Analysis Aquifer Test

REMARKS: