

STATE ENGINEER
Salem, Oregon


CLAC 0305 Well Record

STATE WELL NO. 2/1-12L
COUNTY CLACKAMAS
APPLICATION NO. GR-3128

OWNER: Lester E. Tatreau
MAILING ADDRESS: 3111 SE Concord Rd.

LOCATION OF WELL: Owner's No.
CITY AND STATE: Milwaukie, Oregon

NE 1/4 SW 1/4 Sec. 12 T. 2 S., R. 1 E., W.M.
Bearing and distance from section or subdivision corner 1400' N & 500' W from S 1/4 cor Sec 12

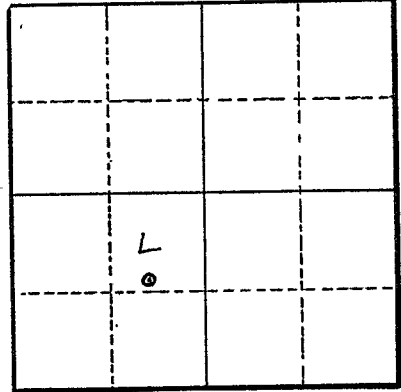

Section 12

Altitude at well

TYPE OF WELL: Drilled Date Constructed 1941

Depth drilled 265' Depth cased 123'

CASING RECORD:
8-inch

FINISH:

AQUIFERS:

WATER LEVEL:
83'

PUMPING EQUIPMENT: Type Pomona H.P. 15
Capacity 300 G.P.M.

WELL TESTS:
Drawdown 9 ft. after 200 hours G.P.M.
Drawdown 18 ft. after 350 hours G.P.M.

USE OF WATER Irrigation Temp. °F., 19

SOURCE OF INFORMATION GR-3976

DRILLER or DIGGER

ADDITIONAL DATA:
Log Water Level Measurements Chemical Analysis Aquifer Test

REMARKS:

