

STATE ENGINEER
Salem, Oregon

CLAC 03065 Well Record

STATE WELL NO. 2/1-13E
COUNTY CLACKAMAS
APPLICATION NO. GR-3188

OWNER: Guy E. Jacques


MAILING ADDRESS: 1765 SW Old River Rd

LOCATION OF WELL: Owner's No.

CITY AND STATE: Oswego, Oregon

SW 1/4 NW 1/4 Sec. 13 T. 2 S., R. 1 E., W.M.

Bearing and distance from section or subdivision corner 300' E & 350' N from W 1/4 corner Sec 13

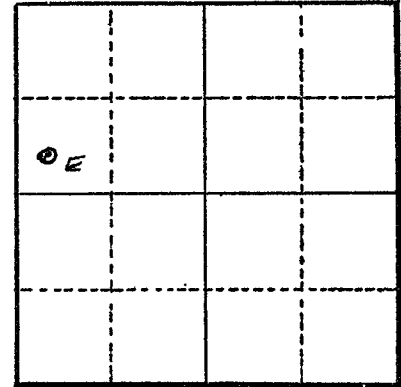

Section 13

Altitude at well

TYPE OF WELL: Drilled Date Constructed 1950

Depth drilled 72' Depth cased 72'

CASING RECORD:

6-inch

FINISH:

AQUIFERS:

WATER LEVEL:

10'

PUMPING EQUIPMENT: Type Pacific Pumping Co H.P. 1
Capacity 860 G.P.M.

WELL TESTS:

Drawdown 25 ft. after 30 hours G.P.M.
Drawdown ft. after hours G.P.M.

USE OF WATER watering Temp. °F. 19

SOURCE OF INFORMATION GR-3892

DRILLER or DIGGER Steinman Bros Drilling Co

ADDITIONAL DATA:

Log NA Water Level Measurements Chemical Analysis Aquifer Test

REMARKS: