

CLAC 307

STATE ENGINEER
Salem, Oregon

CLAC. 00307

Well Record

GR- 1427

STATE WELL NO. 1/1-25J
COUNTY Clackamas
APPLICATION NO. GR- 1478

OWNER: The City of Milwaukie

MAILING ADDRESS:


LOCATION OF WELL: Owner's No. #2

CITY AND STATE:

Milwaukie, Oregon

NE 1/4 SE 1/4 Sec. 25 T. 1 S., R. 1 E. W.M.

Bearing and distance from section or subdivision corner 1630' N. & 600' W. from SE cor. Sec. 25 and/or 100' S. & 55' W. from NE cor. Blk. 7 of the Zanders Addition.

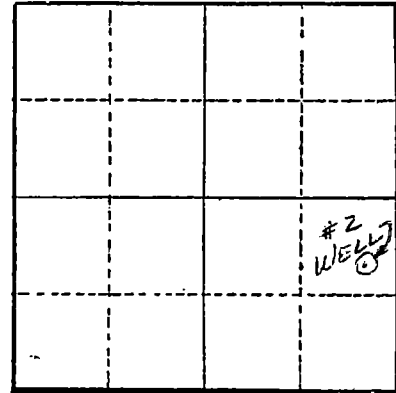

Section 25

Altitude at well 189.26'

TYPE OF WELL: Drilled Date Constructed 1936

Depth drilled 290' Depth cased 189.26'

CASING RECORD:

12" from (100.74' to 189.26' = Elevations)

Corrected per GR record

FINISH:

Perforations 5/15" to 1 1/4", 5 to the ft. per row from 183' to 198' - 8 rows
" " " " " " " " 202' to 214' - 4 rows

AQUIFERS:

WATER LEVEL:

174'

PUMPING EQUIPMENT: Type Worthington Deep Well Turbine H.P. 50
Capacity 615 G.P.M.

WELL TESTS:

Drawdown 69 ft. after hours 557 G.P.M.
Drawdown ft. after hours G.P.M.

USE OF WATER Dom., Ind. & Municipal Temp. °F., 19.

SOURCE OF INFORMATION GR Record

DRILLER or DIGGER

ADDITIONAL DATA:

Log X Water Level Measurements Chemical Analysis Aquifer Test

REMARKS:

