

STATE ENGINEER  
Salem, Oregon

**CLAC 03071 Well Record**

STATE WELL NO. 2/1-13P  
COUNTY Clackamas  
APPLICATION NO. GR-4246

OWNER: Dorothy M. Palmer


MAILING ADDRESS: 18480 S.W. Nixon Avenue

LOCATION OF WELL: Owner's No. \_\_\_\_\_

CITY AND STATE: Oswego, Oregon

SE  $\frac{1}{4}$  SW  $\frac{1}{4}$  Sec. 13 T. 2 N. S., R. 1 E. W., W.M.

Bearing and distance from section or subdivision  
corner 210' NW of 1 1/2 inch pipe marking the NE Cor.  
Plate No. 2 of Cedar oak Park

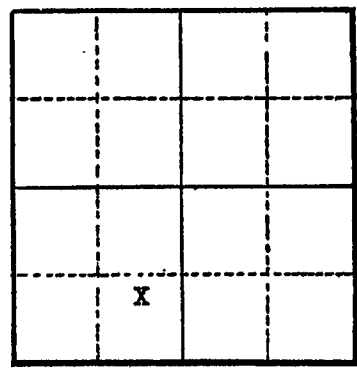

Altitude at well \_\_\_\_\_

TYPE OF WELL: Drilled Date Constructed 4/1/49

Depth drilled 85 ft. Depth cased 40 ft.

Section 13

CASING RECORD:

6 in. threaded and coupled casing from 0 to 40 feet

FINISH:

None

AQUIFERS:

WATER LEVEL:

7 feet below surface

PUMPING EQUIPMENT: Type G. E. jet H.P. 1 1/2  
Capacity 43 G.P.M.

WELL TESTS:

Drawdown \_\_\_\_\_ ft. after \_\_\_\_\_ hours \_\_\_\_\_ G.P.M.  
Drawdown \_\_\_\_\_ ft. after \_\_\_\_\_ hours \_\_\_\_\_ G.P.M.

USE OF WATER Irrigation Temp. \_\_\_\_\_ °F. \_\_\_\_\_, 19 \_\_\_\_\_

SOURCE OF INFORMATION Well Registration Statement Cert. # GR-3781

DRILLER or DIGGER Steinman Brothers

ADDITIONAL DATA:

Log X Water Level Measurements \_\_\_\_\_ Chemical Analysis \_\_\_\_\_ Aquifer Test \_\_\_\_\_

REMARKS:

Log:	Thickness	Depth to Bottom
0' to 30' Grayish sandy clay Not water bearing	30	30
30' to 34' Cement gravel "	4	34
34' to 39' Sand "	5	39
39' to 85' Seamy, gray rock @ 80', 10 gpm @ 85', 21 gpm		

STATE ENGINEER  
Salem, Oregon

CLAC  
03071

# Well Record

STATE WELL NO. 2/1-13K  
COUNTY Clackamas  
APPLICATION NO.

OWNER: Dorothy M. Palmer  
MAILING ADDRESS: 18480 S. W. Nixon Avenue

LOCATION OF WELL: Owner's No.  
CITY AND STATE: Oswego


NW 1/4 SE 1/4 Sec. 13 T. 2 N. S., R. 1 E., W.M.

Bearing and distance from section or subdivision corner

Altitude at well 40'

TYPE OF WELL: Drilled Date Constructed 1949

Depth drilled 85 Depth cased 40

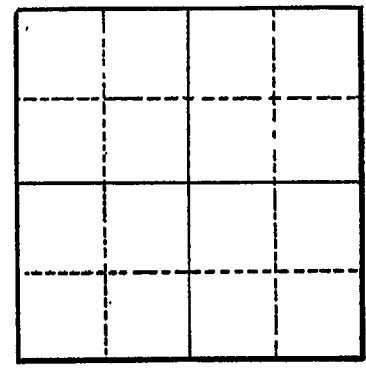

Section

### CASING RECORD:

6-inch - 0 - 40 - to solid rock

### FINISH:

### AQUIFERS:

Rock seams 40' - 85'

### WATER LEVEL:

7

PUMPING EQUIPMENT: Type GE Jet 2600 GPH H.P.  
Capacity G.P.M.

### WELL TESTS:

Drawdown ft. after hours G.P.M.  
Drawdown ft. after hours G.P.M.

USE OF WATER Temp. °F., 19

SOURCE OF INFORMATION Owner  
DRILLER or DIGGER Steinman Bros.

### ADDITIONAL DATA:

Log  Water Level Measurements Chemical Analysis Aquifer Test

### REMARKS:

