

STATE ENGINEER
Salem, Oregon

CLAC 03079

Well Record


STATE WELL NO. 2/1-14G
COUNTY Clackamas
APPLICATION NO. GR-2357

OWNER: Sister Delores Mary MAILING ADDRESS:

LOCATION OF WELL: Owner's No. #2 CITY AND STATE: Marylhurst, Oregon

SW 1/4 NE 1/4 Sec. 14 T. 2 N. S, R. 1 E. W.M.

Bearing and distance from section or subdivision
corner 1,397.4' S. 01° 31' E.

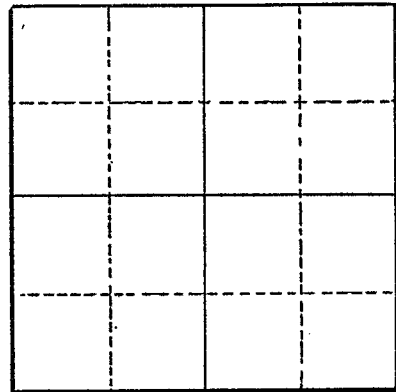

Section

Altitude at well

TYPE OF WELL: Dug Date Constructed 1947

Depth drilled 519 Depth cased 81

CASING RECORD:

12-inch

FINISH:

AQUIFERS:

Clay, sand and rock

WATER LEVEL:

274 feet

PUMPING EQUIPMENT: Type Peerless H.P. 30

Capacity 350 G.P.M.

WELL TESTS:

Drawdown 153 ft. after hours Pumping 95 G.P.M.

Drawdown ft. after hours G.P.M.

USE OF WATER Domestic & irrigation Temp. °F. 19

SOURCE OF INFORMATION GR-2239

DRILLER or DIGGER

ADDITIONAL DATA:

Log Water Level Measurements Chemical Analysis Aquifer Test

REMARKS:

STATE ENGINEER
Salem, Oregon

State Well No. 2/1-14G
County Clackamas
Application No. GR-2357

Well Log

Owner: Sister Delores Mary Owner's No. _____

Driller: _____ Date Drilled _____

CHARACTER OF MATERIAL	(Feet below land surface)		Thickness (feet)
	From	To	
Clay	0	5	5
Brown sand	5	18	13
Sand and gravel	18	35	17
Soft red rock	35	49	14
Cemented gravel	49	64	15
Brown, medium hard rock	64	81	17
Gray, hard rock	81	161	80
Seams in the rock	161	163	2
Hard gray rock	163	174	11
Brown rock	174	181	7
Hard gray rock	181	193	12
Black, medium hard rock	193	209	16
Gray rock	209	213	4
Gray, medium hard rock	213	254	41
Porous red and gray rock with water	254	266	12
Brown rock	266	293	27
Mixture of green, brown & black rock	293	301	8
Gray hard rock	301	351	50
Hard brown rock	351	369	18
Hard gray rock	369	410	31
Hard black rock	410	422	12
Hard gray rock	422	447	25
Porous black rock with water	447	456	9
Gray hard rock	456	476	20

