

CLAC 308

STATE ENGINEER  
Salem, Oregon

CLAC  
00308

Well Record

STATE WELL NO. 1/1-25J  
COUNTY Clackamas  
APPLICATION NO. GR-1480

GR- 1429

OWNER: The City of Milwaukie


MAILING ADDRESS:

LOCATION OF WELL: Owner's No. #3

CITY AND STATE: Milwaukie, Oregon

NE 1/4 SE 1/4 Sec. 25 T. 1 N. S., R. 1 E. W.M.

Bearing and distance from section or subdivision corner 265' S. & 275' W. from NE cor. Blk. 7 of the Zanders Addition.

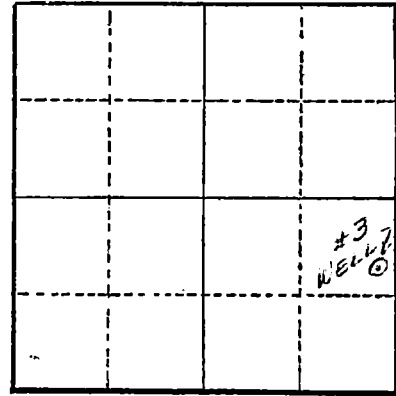

Section 25

Altitude at well 189.26'

TYPE OF WELL: Drilled Date Constructed 1946

Depth drilled 290' Depth cased 188.26'

CASING RECORD:

12" from 101.74 to 188.26'

Corrected via GR record

FINISH:

Perforations: 5/15" to 1 1/4" (5/ft./row from 224' to 238' - 4 rows  
" " " " " 265' to 279' - 4 rows

AQUIFERS:

WATER LEVEL:

174'

PUMPING EQUIPMENT: Type Worthington turbine H.P. 50  
Capacity 650 G.P.M.

WELL TESTS:

Drawdown 35 ft. after 585 hours G.P.M.  
Drawdown ft. after hours G.P.M.

USE OF WATER Dom., Ind., & Municipal Temp. °F., 19  
SOURCE OF INFORMATION GR Record

DRILLER or DIGGER

ADDITIONAL DATA:

Log X Water Level Measurements Chemical Analysis Aquifer Test

REMARKS:

See Application #GR-1478 for log as these are identical

