

STATE ENGINEER
Salem, Oregon

CLAC Well Record
03090


STATE WELL NO. 2/1-15A(1)
COUNTY Clackamas
APPLICATION NO. GR-574

OWNER: Glenmorrie Coop. Ass'n. MAILING ADDRESS: 252 S.W. Glenmorrie Drive

LOCATION OF WELL: Owner's No. CITY AND STATE: Oswego, Oregon

NE 1/4 NE 1/4 Sec. 15. T. 2 N. S, R. 1 E. W., W.M.

Bearing and distance from section or subdivision
corner 336 feet S. & 76 feet W. of Section
corner common to Section 10, 11, 14 & 15

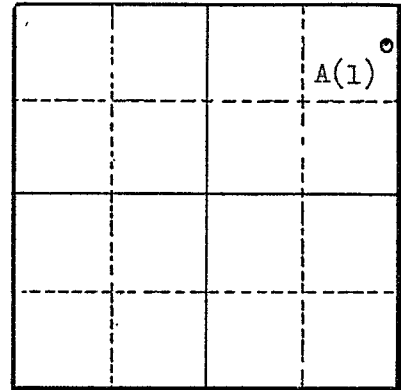

Altitude at well 270

TYPE OF WELL: Drilled Date Constructed May '48

Depth drilled 427 Depth cased 62

Section 15

CASING RECORD:

8-inch

FINISH:

AQUIFERS:

WATER LEVEL:

128 feet

PUMPING EQUIPMENT: Type Rotary H.P. 10
Capacity 75 G.P.M.

WELL TESTS:

Drawdown ft. after hours G.P.M.
Drawdown ft. after hours G.P.M.

USE OF WATER Municipal 86 families Temp. °F. 19

SOURCE OF INFORMATION GR-574

DRILLER or DIGGER

ADDITIONAL DATA:

Log x Water Level Measurements Chemical Analysis Aquifer Test

REMARKS:

