

STATE ENGINEER
Salem, Oregon

CLAC 03094 Well Record

STATE WELL NO. 2/1-15F
COUNTY Clackamas
APPLICATION NO. GR-3731

OWNER: Mrs. A. V. Petersen


MAILING ADDRESS: Rolling Hill Farm-Bergis Road

LOCATION OF WELL: Owner's No.

CITY AND STATE: Oswego, Oregon

SE 1/4 NW 1/4 Sec. 15 T. 2 N. S. R. 1 E. W.M.

Bearing and distance from section or subdivision
corner 1400 feet East and 1600 feet South from
the NW Corner, Section 15.

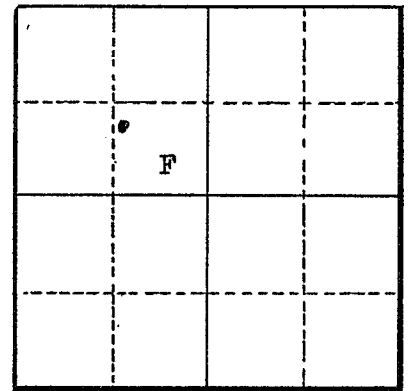

Section 15

Altitude at well 500 feet

TYPE OF WELL: Drilled Date Constructed 1935

Depth drilled 350 feet Depth cased

CASING RECORD:

FINISH:

AQUIFERS:

WATER LEVEL:

200 to 275 feet

PUMPING EQUIPMENT: Type Red Jacket H.P.

Capacity 30 G.P.M.

WELL TESTS:

Drawdown ft. after hours G.P.M.

Drawdown ft. after hours G.P.M.

USE OF WATER Irrigation Temp. °F. 19

SOURCE OF INFORMATION GR-4064

DRILLER or DIGGER

ADDITIONAL DATA:

Log (NA) Water Level Measurements Chemical Analysis Aquifer Test

REMARKS: