

STATE ENGINEER
Salem, Oregon

CLAC

03095

Well Record

STATE WELL NO. 2/1-15F
COUNTY Clackamas
APPLICATION NO. GR-3378

OWNER: Adelaide W. Rush

MAILING ADDRESS: 17315 SW Carnell Rd.


LOCATION OF WELL: Owner's No.

CITY AND STATE: Oswego, Oregon

SE 1/4 NW 1/4 Sec. 15 T. 2 N S., R. 1 W., W.M.

Bearing and distance from section or subdivision

corner 1850' E. and 1200' N.

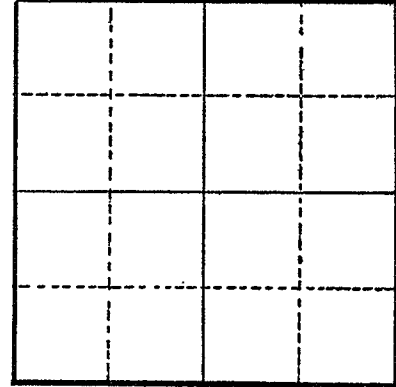

Section

Altitude at well

TYPE OF WELL: drilled Date Constructed prior 1950

Depth drilled 347' Depth cased 347'

CASING RECORD:

6"

FINISH:

AQUIFERS:

WATER LEVEL:

PUMPING EQUIPMENT: Type F. M. piston H.P.
Capacity 10-12 G.P.M.

WELL TESTS:

Drawdown ft. after hours G.P.M.

Drawdown ft. after hours G.P.M.

USE OF WATER Irrigation Temp. °F., 19

SOURCE OF INFORMATION GR-3122

DRILLER or DIGGER

ADDITIONAL DATA:

Log Water Level Measurements Chemical Analysis Aquifer Test

REMARKS: