


STATE ENGINEER
Salem, Oregon

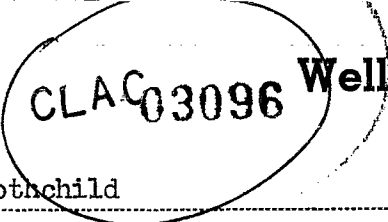

Well Record

STATE WELL NO. 2/1-15G
COUNTY Clackamas
APPLICATION NO. GR-3392

OWNER: J. M. Rothchild


MAILING ADDRESS: 410 SW Bergis Rd.

LOCATION OF WELL: Owner's No.

CITY AND STATE: Oswego, Oregon

SW 1/4 NE 1/4 Sec. 15 T. 2 N. S., R. 1 E. W., W.M.

Bearing and distance from section or subdivision corner S. 43°30' W. 3305'

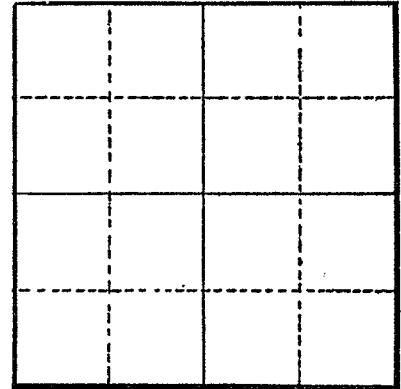

Section

Altitude at well

TYPE OF WELL: drilled Date Constructed 1939

Depth drilled 436' Depth cased

CASING RECORD:

FINISH:

AQUIFERS:

WATER LEVEL:

PUMPING EQUIPMENT: Type Beresford Submersible H.P. 7 1/2
Capacity 25 G.P.M.

WELL TESTS:

Drawdown ft. after hours pumping 25 G.P.M.
Drawdown ft. after hours G.P.M.

USE OF WATER Irrigation Temp. °F., 19

SOURCE OF INFORMATION GR-3131

DRILLER or DIGGER A. M. Jonnsen Drilling Co. 21075 SW Tualatin Valley Hwy. Aloha, Or

ADDITIONAL DATA:

Log Water Level Measurements Chemical Analysis Aquifer Test

REMARKS: