

STATE ENGINEER
Salem, Oregon

CLAG
03097

Well Record

STATE WELL NO. 2/1-15K
COUNTY Clackamas
APPLICATION NO. GR-2424

OWNER: Ferry Smith - Skylands Water Co.


MAILING ADDRESS: #312 Board of Trade Building

LOCATION OF WELL: Owner's No. _____

CITY AND STATE: Portland, Oregon

NW 1/4 SE 1/4 Sec. 15 T. 2 S., R. 1 W., W.M.

Bearing and distance from section or subdivision
corner 2250' W & 300' N from E 1/4 corner Section 15

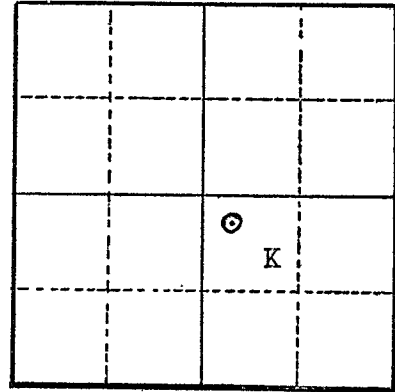

Section 15

Altitude at well _____

TYPE OF WELL: Drilled Date Constructed 1948

Depth drilled 470' Depth cased _____

CASING RECORD: _____

FINISH: _____

AQUIFERS: _____

WATER LEVEL:

364'

PUMPING EQUIPMENT: Type A. D. Cook deep well Turbine H.P. 15
Capacity 74 G.P.M.

WELL TESTS:

Drawdown 66 ft. after _____ hours 74 G.P.M.

Drawdown _____ ft. after _____ hours _____ G.P.M.

USE OF WATER Domestic Temp. _____ °F. _____, 19____

SOURCE OF INFORMATION GR-3897

DRILLER or DIGGER _____

ADDITIONAL DATA:

Log NA Water Level Measurements _____ Chemical Analysis _____ Aquifer Test _____

REMARKS: _____