

STATE ENGINEER  
Salem, Oregon

Well Record  
CLAC 00318


STATE WELL NO. 1/1-26R  
COUNTY CLACKAMAS  
APPLICATION NO. GR-2877

OWNER: Omark Industries, Inc MAILING ADDRESS: 9701 SE McLoughlin Blvd

LOCATION OF WELL: Owner's No. CITY AND STATE: Oregon

SE 1/4 SE 1/4 Sec. 26 T. 1 S., R. 1 E., W.M.

Bearing and distance from section or subdivision  
corner 466' S 50°36' E of SE corner Lot 11 Milwaukie  
Industrial Park.

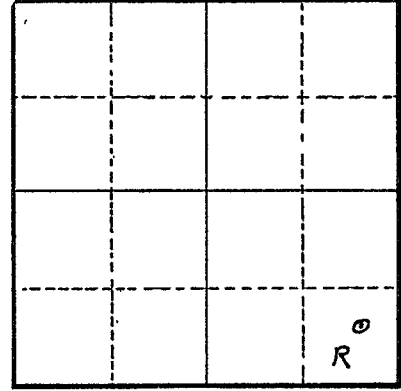

Section 26

Altitude at well

TYPE OF WELL: Drilled Date Constructed 1955

Depth drilled 381' Depth cased 381'

CASING RECORD:

12- inch surface to 96'  
10- inch surface to 267'  
8- inch 265' to 381'

FINISH:

8-inch casing perforated 271' to 381'

AQUIFERS:

WATER LEVEL:

close to surface

PUMPING EQUIPMENT: Type Layne & Bowler, deep well turbine, H.P. 25  
Capacity 275 G.P.M.

WELL TESTS:

Drawdown 300 ft. after 322 hours G.P.M.  
Drawdown 240 ft. after 277 hours G.P.M.

USE OF WATER Air-conditioning Temp. °F., 19

SOURCE OF INFORMATION GR-3911

DRILLER or DIGGER

ADDITIONAL DATA:

Log  Water Level Measurements  Chemical Analysis  Aquifer Test

REMARKS:

STATE ENGINEER  
Salem, Oregon

State Well No. 1/1-26R

County CLACKAMAS

Application No. GR-2877

## Well Log

Owner: Omark Industries, Inc.

Owner's No.

Driller:

Date Drilled 1955

CHARACTER OF MATERIAL	(Feet below land surface)		Thickness (feet)
	From	To	
Topsoil and gravel	surface	4	4
Gravel	4	5	1
Boulders and gravel	5	20	15
Mucky sand	20	29	9
Hard Broken rock	29	43	14
Cemented gravel	43	75	32
Conglomerate	75	89	14
Medium hard grey rock with red seams	89	140	51
Mixed colored rock mostly grey and red	140	179	39
Hard grey rock	179	196	17
Conglomerate	196	213	17
Soft grey rock with red seams	213	217	4
Conglomerate	217	219	2
Soft grey rock	219	223	4
Conglomerate	223	237	14
Rough broken grey rock	237	240	3
Shale, broken brown	240	257	17
Grey rock	257	262	5
Grey rock with shale seams	262	273	11
Medium hard grey rock	273	296	23
Grey rock with red seams (water bearing)	296	318	22
Medium Hard rough grey rock	318	331	13
Hard rough grey rock (water bearing)	331	381	50