

STATE ENGINEER
Salem, Oregon

OBSERVATION WELL

Well Record

STATE WELL NO. 2/1-21N
COUNTY Clackamas
APPLICATION NO. GR-1501

CLAC 03246 GR 1452

OWNER: Paul E. & Ethel May Riegelmann


MAILING ADDRESS: Rt. 1, Box 268

LOCATION OF WELL: Owner's No. #1

CITY AND STATE: West Linn, Oregon

SW 1/4 SW 1/4 Sec. 21 T. 2 S., R. 1 W.M.

Bearing and distance from section or subdivision
corner 300' E. & 200' N. from SW cor. Sec. 21

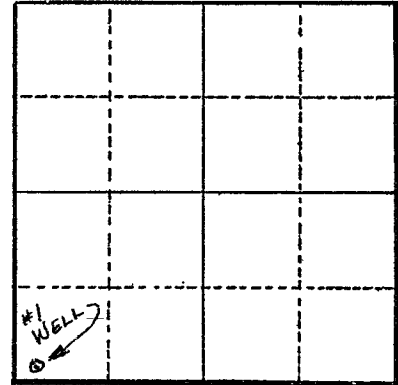

Section 21

Altitude at well 185'

TYPE OF WELL: Drilled Date Constructed 1946

Depth drilled 330' Depth cased 315'

CASING RECORD:
6"

FINISH:

AQUIFERS:

WATER LEVEL:
40'

PUMPING EQUIPMENT: Type Myers jet H.P. 1
Capacity 30 G.P.M.

WELL TESTS:
Drawdown 110 ft. after 15 hours G.P.M.
Drawdown 80 ft. after 10 hours G.P.M.
Drawdown 160 ft. after 25 hours G.P.M.

USE OF WATER Irrigation Temp. °F. 19

SOURCE OF INFORMATION GR Record

DRILLER or DIGGER F. W. Livermore

ADDITIONAL DATA:

Log Water Level Measurements Chemical Analysis Aquifer Test

REMARKS:

Log: Clay, blue 0 to 315 ft.
Gravel 315 to 330 ft.

Irrigation of 1.5 acres.