

STATE ENGINEER
Salem, Oregon

CLAC

03375

Well Record

STATE WELL NO. 2/1-24
COUNTY CLACKAMAS
APPLICATION NO. GR-2377

OWNER: Robinwood Water District, a municipal water district
MAILING ADDRESS: 165 S.W. Arbor Drive
CITY AND STATE: Oswego, Oregon

LOCATION OF WELL: Owner's No.

NW $\frac{1}{4}$ NW $\frac{1}{4}$ NW $\frac{1}{4}$ Sec. 24 T. 2 S., R. 1 E., W.M.

Bearing and distance from section or subdivision corner 1002.96' S. and 725.60' E.

Altitude at well

TYPE OF WELL: Drilled Date Constructed 1946

Depth drilled 278 Depth cased 140

CASING RECORD:

8-inch

FINISH:

AQUIFERS:

WATER LEVEL:

137-feet

PUMPING EQUIPMENT: Type Deming Deep Well Turbine H.P. 20
Capacity 300 G.P.M.

WELL TESTS:

Drawdown 43 ft. after hours Pumping 100 G.P.M.
Drawdown 62 ft. after hours Pumping 200 G.P.M.

USE OF WATER Municipal water district Temp. °F., 19


SOURCE OF INFORMATION GR-2259

DRILLER or DIGGER S. M. Munson, 3636 N.E. Simpson St., Portland, Oregon (Deceased)

ADDITIONAL DATA:

Log Water Level Measurements Chemical Analysis Aquifer Test

REMARKS:

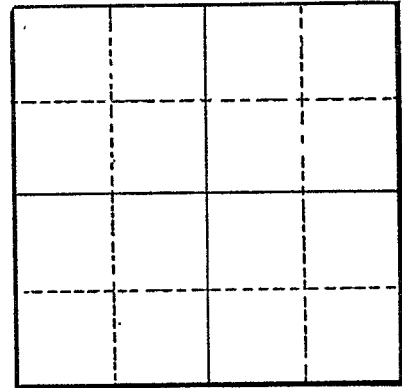

Section