

STATE ENGINEER  
Salem, Oregon

CLAC' 00356

# Well Record

STATE WELL NO. 1/2-30B  
COUNTY CLACKAMAS  
APPLICATION NO. GR-2878

OWNER: Omark Industries, Inc.


MAILING ADDRESS: 9701 SE McLoughlin Blvd

LOCATION OF WELL: Owner's No.

CITY AND STATE: Oregon

NW 1/4 NE 1/4 Sec. 30 T. 1 S., R. 2 E., W.M.

Bearing and distance from section or subdivision corner 1288' S 30°36' W of NE cor of Geo. Willie DLC

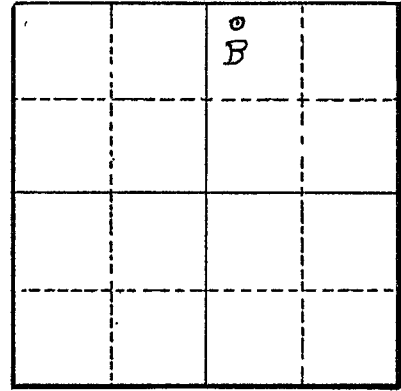

Section 30

Altitude at well

TYPE OF WELL: Drilled Date Constructed 1955

Depth drilled 116' Depth cased 116'

CASING RECORD:  
8-inch

FINISH:

AQUIFERS:

WATER LEVEL:  
10'

PUMPING EQUIPMENT: Type Johnson Johnson JGM H.P. 5  
Capacity 150 G.P.M.

WELL TESTS:  
Drawdown 13 ft. after hours 105 G.P.M.  
Drawdown ft. after hours G.P.M.

USE OF WATER process water-manufacturing Temp. °F., 19  
SOURCE OF INFORMATION GR-3912

DRILLER or DIGGER

ADDITIONAL DATA:  
Log  Water Level Measurements Chemical Analysis Aquifer Test

REMARKS:

