

WATER WELL REPORT

State Well No. 2/1-29

STATE OF OREGON

State Permit No.

ORIGINAL  
Duplicate with the  
STATE ENGINEER  
SALEM, OREGON

CLAC  
03583

(1) OWNER:

E. K. Gustin  
Route 1, Box 140  
Sherwood Oregon

(11) WELL TESTS:

Drawdown is amount water level is lowered below static level  
Was a pump test made?  Yes  No If yes, by whom?  
Yield: gal./min. with ft. drawdown after hrs.  
Bailer test 15 gal./min. with 10 ft. drawdown after 4 hrs.  
Artesian flow g.p.m. Date  
Temperature of water Was a chemical analysis made?  Yes  No

(2) LOCATION OF WELL:

Clackamas Owner's number, if any—  
¼ Section T. R. W.M.  
and distance from section or subdivision corner

(12) WELL LOG:

Diameter of well 6 inches.  
Depth drilled 20 ft. Depth of completed well 245 ft.  
Formation: Describe by color, character, size of material and structure, and show thickness of aquifers and the kind and nature of the material in each stratum penetrated, with at least one entry for each change of formation.

MATERIAL	FROM	TO
Blue basalt	225	241
Brown Rock & scapstr.	241	245

(3) TYPE OF WORK (check):

New Well  Deepening  Reconditioning  Abandon   
If abandonment, describe material and procedure in Item 11.

PROPOSED USE (check):

Domestic  Industrial  Municipal   
Irrigation  Test Well  Other

(5) TYPE OF WELL:

Rotary  Driven   
Cable  Jetted   
Dug  Bored

(6) CASING INSTALLED:

Threaded  Welded

8" Diam. from 0 ft. to 120 ft. Gage 5/16  
" Diam. from ft. to ft. Gage  
" Diam. from ft. to ft. Gage

PERFORATIONS:

Perforated?  Yes  No

of perforator used  
of perforations in. by in.  
perforations from ft. to ft.  
perforations from ft. to ft.  
perforations from ft. to ft.  
perforations from ft. to ft.  
perforations from ft. to ft.

(8) SCREENS:

Well screen installed  Yes  No

Manufacturer's Name \_\_\_\_\_  
Type \_\_\_\_\_ Model No. \_\_\_\_\_  
Diam. \_\_\_\_\_ Slot size \_\_\_\_\_ Set from ft. to ft.  
Slot size \_\_\_\_\_ Set from ft. to ft.

(9) CONSTRUCTION:

Was well gravel packed?  Yes  No Size of gravel: \_\_\_\_\_  
Gravel placed from ft. to ft.  
Surface seal provided?  Yes  No To what depth? \_\_\_\_\_ ft.  
Material used in seal—  
Do any strata contain unusable water?  Yes  No  
Depth of water? \_\_\_\_\_ Depth of strata \_\_\_\_\_  
Method of sealing strata off \_\_\_\_\_

(10) WATER LEVELS:

Static level 203 ft. below land surface Date 4-17-58  
Artesian pressure \_\_\_\_\_ lbs. per square inch Date \_\_\_\_\_

Log Accepted by:

[Signed] E. K. Gustin Date 4/24, 1958 (Owner)

(13) PUMP:

Manufacturer's Name Pacific Pump  
Type Submersible H.P. 1

Well Driller's Statement:


This well was drilled under my jurisdiction and this report is true to the best of my knowledge and belief.

NAME SIMONS & GREGORY (Person, firm, or corporation) (Type or print)  
Address 6421 S.W. Garden Home Rd Portland

Driller's well number \_\_\_\_\_  
[Signed] E. M. Gregory (Well Driller)  
License No. 99 Date 4-22, 1958

# Legal description of property

All that part of the tract of land described in deed recorded in Volume 159 on page 448, record of deeds for Clackamas County Oregon lying East of Market Road #12, and North of Market Road #14, and being in the John Riley D.L.C. in section 29, T. 2 S., R.1 E., W.M.

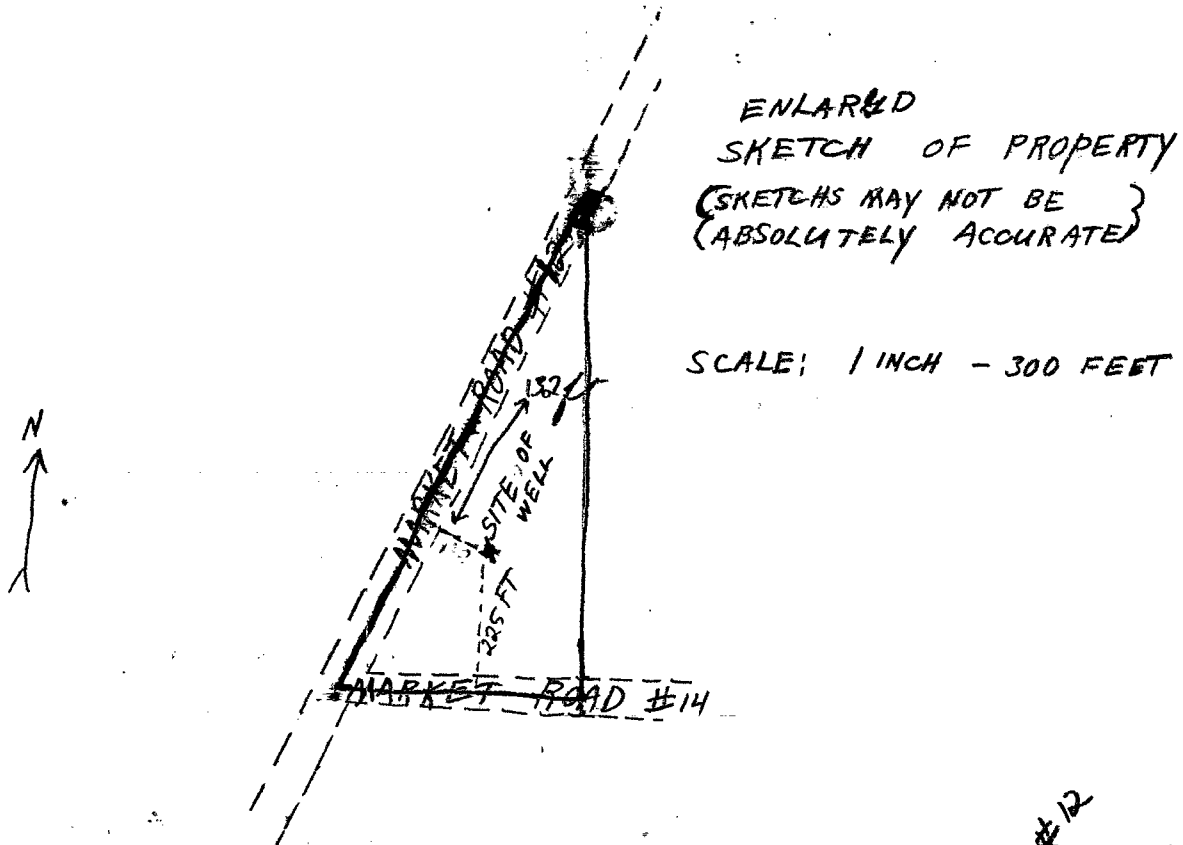

SKETCH OF DONATION LAND CLAIM OF JOHN RILEY

SCALE 1 INCH - 900 FEET

