
NOTICE TO WATER WELL CONTRACTOR
The original and first copy

## The original and first copy of this report are to be filed with the RECEIVATER WELL REPORT RECEIVATER WELL REPORT (Please type or print) AUG 25 197 not write above this line)

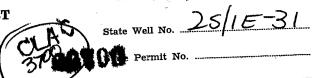

STATE ENGINEER, SALEM, OREGON 97310

WATER RESOURCES DEPT.	The second of th	_		
OWNER: SALEM, OREGON	(10) LOCATION OF WELL:  Output: Claskswar Driller's well 1	number		
John Davie			12.	w.m.
Rt. 2 Box 170	½ ½ Section 31 T. 28			
ddress Aurora, Oregon	Bearing and distance from section or subdivi	sion corner		F. 3
2) TYPE OF WORK (check):				. mu
Abandon [	To the second se			<u> </u>
Tew Well Deepening Reconditioning Abandon Statement, describe material and procedure in Item 12.	(11) WATER LEVEL: Completed	well.		
	Depth at which water was first found 305		<del></del>	<u>ft.</u>
J 1111 01 11-	## pelow land	surface. I	oate <u>7</u>	<u>-14-</u> 7
Rotary Driven Domestic Industrial Municipal Domestic Industrial Other Irrigation Test Well Other	Artesian pressure lbs. per square inch. Date			,*•
CASING INSTALLED: Threaded □ Welded 250  " Diam. from ft. to ft. Gage 7  " Diam. from ft. to ft. Gage 7  " Diam. from ft. to ft. Gage 7	(12) WELL LOG: Diameter of well below casing 6  Depth drilled 325 ft. Depth of completed well 325 ft.  Formation: Describe color, texture, grain size and structure of materials; and show thickness and nature of each stratum and aquifer penetrated, with at least one entry for each change of formation. Report each change in position of Static Water Level and indicate principal water-bearing strata.			
PERFORATIONS: Perforated?   Yes  No.	position of Static Water Level and thatcase p	1		
	MATERIAL	From	То	SWL
type of perforator used	Organie	0	1	
Size of perforations in. by in.	Red elay	1	10	
perforations from	Brown elay	10	42	
perforations from ft. to	Fractured brown basalt	42	45	
perforations fromft. toft.	Brown basalt	45	100	
	Red Basalt	100	108	
(7) SCREENS: Well screen installed?   Yes   No		198	135	
Manufacturer's Name	Brown basalt	135	138	
TypeModel No.	Red basalt	130	170	
Diam. Slot size Set from ft. to ft.	Black basalt	170	235	
Diam. Slot size Set from tt. to tt.	Brown basalt	235	237	
	Red basalt			
(8) WELL TESTS: Drawdown is amount water level is lowered below static level	Black basalt	237	255	
· ·	Red basalt	255	270	
Was a pump test made? Wes Do If yes, by whom? Driller	Grey basalt	279	305	
Was a pump test made? If yes   No ii yes, 59   No ii yes   Yield: 30   gal./min. with 30   ft. drawdown after 1   hrs		305	325	
The state of the s				
et drowdown after hrs				
Bailer test gal./min. with it. drawdown	<b>-</b>			
Artesian flow g.p.m.  Temperature of water Depth artesian flow encountered fi	Work started 7-12 19 77 Com	pleted	7-14	19
Temperature of water	Date well drilling machine moved off of w	ell	7-14	19
CONSTRUCTION:				
Cement	Drilling Machine Operator's Certificate This well was constructed under	my direc	t super	visio
50	This well was constructed under Materials used and information repo	rted above	are tru	e to m
Well sealed from land surface to 10 18 to 25 to	best knowledge and belief,			
Diameter of well bore to bottom of seal	[Signed] (Drilling Machine Operator)	Date	1-12	, 19
Diameter of well bore below seal in.	(Drilling Machine Operator)	3Y.	60	7
Number of sacks of cement used in Weil seal	Drilling Machine Operator's License	NO		· · · · · · · · · · · · · · · · · · ·
Number of sacks of bentonite used in wen sear				
Brand name of bentonite	Water Well Contractor's Certification:	:		
Number of pounds of bentonite per 100 gallons  1bs./100 gal	This well was drilled under my justified to the best of my knowledge and	risdiction i belief.	and this	report
of water	A C Transala land			
Was a drive shoe used? ☐ Yes ☐ No Plugs	(Person, firm or corporation)		(Type or pr	
depth of strata	_ Address	miston,		<u> </u>
Method of sealing strata off	- [Signed]	un	<i>-</i>	
West Woods I Ves W No Size of gravel:	Y (W)	Contractor)	1 le	
Was well graver packed.	Contractor's License No. / Da	te	14	, 19
Gravel placed from ft. to ft.				SP*45656-