

STATE ENGINEER
Salem, Oregon

CLAC
3729

Well Record


STATE WELL NO. 2/1-31C
COUNTY CLACKAMAS
APPLICATION NO. GR-1731

OWNER: Marvin H. Delker
MAILING ADDRESS: Rt. 1 Box 279

LOCATION OF WELL: Owner's No. _____
CITY AND STATE: Sherwood, Oregon

NE 1/4 NW 1/4 Sec. 31 T. 2 S., R. 1 E., W.M.

Bearing and distance from section or subdivision corner 452' S & 246' W from the N corner

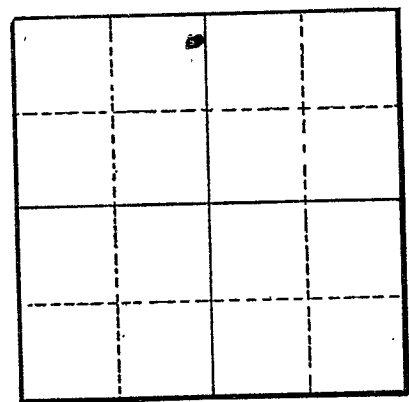

Section 31

Altitude at well _____

TYPE OF WELL: Drilled Date Constructed 1951

Depth drilled 148' Depth cased 40'

CASING RECORD:

8-inch

FINISH:

None

AQUIFERS:

Clay
Rock

WATER LEVEL: 120'

PUMPING EQUIPMENT: Type Peerless Turbine H.P. 7 1/2
Capacity 100 G.P.M.

WELL TESTS:
Drawdown 30 ft. after _____ hours 100 G.P.M.
Drawdown _____ ft. after _____ hours _____ G.P.M.

USE OF WATER Irrigation Temp. _____ °F. _____, 19____

SOURCE OF INFORMATION GR-3831
DRILLER or DIGGER Miller, Aurora, Oregon

ADDITIONAL DATA:
Log Water Level Measurements _____ Chemical Analysis _____ Aquifer Test _____

REMARKS:

Clay 20'
Rock 128'