

STATE ENGINEER
Salem, Oregon

CLAC 00375

Well Record

STATE WELL NO. 1/2-32
COUNTY Clackamas
APPLICATION NO. GR-1905

OWNER: D. F. Bixby


MAILING ADDRESS: 6424 Monroe Rd

LOCATION OF WELL: Owner's No.

CITY AND STATE:

NW 1/4 NW 1/4 Sec. 32 T. 1 N. S. R. 2 E. W.M.

Bearing and distance from section or subdivision corner 550' S. & 940' E. of NW cor. of Sec.

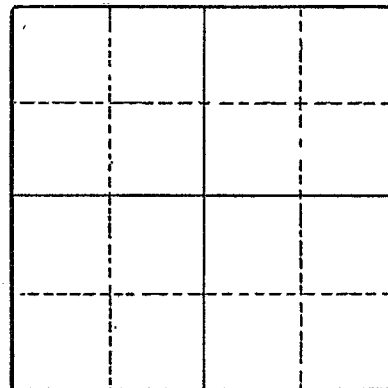

Section 32

Altitude at well

TYPE OF WELL: Drilled Date Constructed 1942

Depth drilled 115 Depth cased 115

CASING RECORD:

6-inch, 0 to 115 feet

FINISH:

Perforated

AQUIFERS:

Unknown

WATER LEVEL:

87 feet

PUMPING EQUIPMENT: Type Deming 12" Plunger H.P. 1 1/2
Capacity 15 G.P.M. Elec.

WELL TESTS:

Drawdown ft. after hours G.P.M.

Drawdown ft. after hours G.P.M.

USE OF WATER Irrigation Temp. °F., 19

SOURCE OF INFORMATION GR-1905

DRILLER or DIGGER

ADDITIONAL DATA:

Log Water Level Measurements Chemical Analysis Aquifer Test

REMARKS: